

MONROE
C 83
CL-1755
1/30/81

MISSISSIPPI
BOARD OF WATER COMMISSIONERS
416 North State Street
Jackson, Mississippi 39201

CODED

WATER WELL DRILLERS LOG

1-30 1981 Layne-Central Co. Monroe
date well completed firm name county well located

LANDOWNER:
Glenn Farms
Amory, MS
(mailing address)

WELL LOCATION:
sec. 35-T-12N R-8 E
1 miles SW of Amory
(distance) (direction) (nearest town)

WELL PURPOSE: irrigation
(home, irrigation, municipal, industrial)

WELL COMPLETION DATA:
(1) diameter (inches) 28"
(2) total depth (feet) 284'
(3) static water level (feet) 16' below top of ground.
(4) casing Steel 244'
(material) (depth)
12" if telescope see back.
(size)
(5) screen 40' 244'
12" (length) (depth to top)
St. steel
(size) (material)
(6) pump 30 1200
(HP) (yield gpm)
Diesel
(type power)
(7) electric log no
(yes or no)
(organization running log)
st. plate
(8) how well bottom plugged

description of formations encountered	from	to
Clay	0	43
Fine sand & clay	43	56
Clay	56	86
Gravel	86	92
Clay	92	135
Line	135	152
Clay	152	154
Gumbo clay	154	192
Rock	192	194
Clay	194	196
Rock	196	199
Clay	199	238
Sand & Gravel	238	286

DRILLERS REMARKS:


DEPT. OF NATURAL RESOURCES
BUREAU OF LAND & WATER RESOURCES

FEB 19 1981
RECEIVED

(X)

If well telescopes please sketch and show depths.

GROUND LEVEL

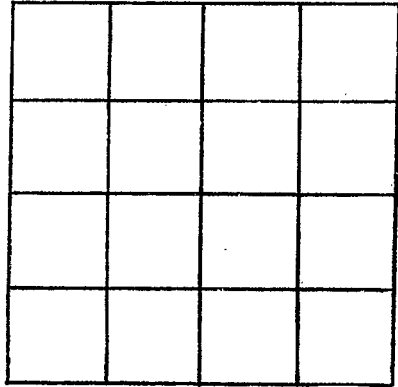

SECTION _____

Please indicate well location X.

ADDITIONAL INFORMATION

A series of horizontal lines providing space for additional information. The lines are evenly spaced and extend across the width of the page.

If more than one screen, show locations of each on sketch.