

MONROE

84

10/84

MISSISSIPPI  
 BOARD OF WATER COMMISSIONERS  
 416 North State Street  
 Jackson, Mississippi 39201

WATER WELL DRILLERS LOG

CODE

1984 Herndon Well & Supply, Inc.

date well completed

firm name

county well

LANDOWNER: Town of Hatley  
 Rt. 3, Box 811  
 Amory, MS 38821

Water Well No. 2

(mailing address)

WELL LOCATION:

sec. 34 T. 12 N. R. 18 E.  
 S W

Inside City Limits

(distance) miles (direction) of (nearest town)

WELL PURPOSE: Municipal  
 (home, irrigation, municipal, industrial)

WELL COMPLETION DATA:

- (1) diameter (inches) 12 x 6"
- (2) total depth (feet) 321'
- (3) static water level (feet) 84' below top of ground. ~~xxxx~~
- (4) casing Steel 282'  
 (material) (depth)  
12" if telescope see back.  
 (size)
- (5) screen 41' 280'  
 (length) (depth to top)  
6" SS Ribbed  
 (size) (material)
- (6) pump 25 272  
 (HP) (yield gpm)  
electric  
 (type power)
- (7) electric log yes  
 (yes or no)  
Herndon Well & Supply  
 (organization running log)
- (8) how well bottom plugged 6" BWV

description of fomations encountered

from

Red Clay	0	8
Coarse Sand & Chalk	8	80
Rock		80
Coarse Sand	80	85
Blue Clay & Sand	85	180
Rock		180
Blue Clay & Sand	180	200
Coarse White Sand	200	312
Gravel	312	355
Coarse Sand	355	360

CODED

28 2 1/2

MISSISSIPPI DEPT. OF NATURAL RESOURCES  
 BUREAU OF LAND & WATER RESOURCES


NOV 7 1984

RECEIVED

DRILLERS REMARKS:

If well telescopes please sketch and show depths.

ND LEVEL

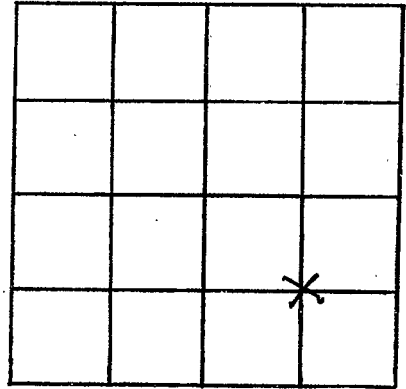

SECTION 34

Please indicate well location X.

ADDITIONAL INFORMATION

Top of Lap  
252'

Top of Screen  
280'

CASING  
282'

Bottom Screen  
321'

If more than one screen,  
show locations of each on sketch.