	· · · ·	ell Report	For Office Use Only:
County: Morrol	Part 1 – Driller's Log		Amifan
Permit #:	Mississippi Department of Environmental Quality Office of Land and Water Resources		Aquifer:
Driller: Thomas Rossi (0509)	1	lox 10631	Well #: <u>Cl21</u>
Driller: [ 104 a3 1 1035] [0309]	Jackson, M	S 39289-0631	L. S. Elevation:
Date drilling completed: 2-4-13		961-5210	
	(601)354	I-6938 (fax)	E-log #:
State Law requires that this repo			
Department at the above address within 30 days of completi Information on Well Owner		Well or Borehole Location	
(Landowner if borehole is not f	or a water well)	T 1 22 150	· · · · · · · · · · · · · · · · · · ·
Dwner Name Martha De	Dalquine	Latitude: 33 * 37 (01	" Longitude: <u>88° 31 ' 40 "</u>
~		Method of Lat/Long (circle on	e): Conventional Survey,
Mailing Address: P.O. BUC 21(	)		
		USGS quad, Hand-held	
Λ. ι.	5 38521	S 14 W 14 Sec 27 Distance Direction	Twn DE Rng HE
Amory M.		IR IR	125 19W
City Sta		Distance Direction $\underline{3}$ Miles $\underline{\sqrt{657}}$ of	Nearest Iown
Telephone No. 662 256-3	558		0
		-l- D-A-	
_	Well / Borel		
Date drilling started: 1-29-13 Date da	illing completed: 24-13	Hole depth: 🔔 24	Hole diameter: <u>§</u>
		· · · · · · · · · · · · · · · · · · ·	
ocation of the source of any surface wat Method of dosing and volume of Chlorin	e used in drilling and develo	opment:	Ju Syster
.ogs run (circle all applicable): No log ru	n)Electric Gamma Rav	Density Sonic Neutron (	)ther:
Name of organization running log(s):			
urpose of borehole (check one): Water W	ell 1/ Geotechnical/Geolo	ogical Investigation Ground	Source Heat Pump
-	- <b>-</b> -		
Seismic	Survey Other ( <i>describe</i> )	n, skip the remainder of this blo	
(			
Purpose of Well (check one): Home $\sqrt{2}$	ndustrial Public Supply	Irrigation Fish Culture	Other:
f a flowing well, method of flow regulation	on: Valve Of	ther (describe)	
static Water Level: <u>/ S ()</u> feet a			
Method of Measurement (circle one)			
Vell depth: <u>LL4</u> Well grouted to a de	pth offeet Type	of grout (circle one) Neat Ceme	ent) Bentonite Mix
Casing length: <u>204</u> feet Casi	ng diameter: <u>4</u> <sup></sup>	_inches Type of casing:	PVC
creen length: <u>20</u> feet Scre	en diameter: /	_inches Type of screen:	° v C
creen slot size: 0 / 0inches	Setting depth: From	204 feet to 20	<u> </u>
ype of completion (circle all applicable):	Gravel packed Undern	reamed Telescoped Open I	nole Natural Development
	Other (describe):		
op of lap pipe or reduction in casing:	feet If tol	escoped or more than one scree	n. describe on next page

.

.

MAY 02 2013

BY: OLWR

## The sketch below only required for water wells

If well telescopes, show	<u>depths on sketch.</u>
--------------------------	--------------------------


Ground Level

Ground Level
Samitoravy 15
«land Roll
Flahr HO
Rock
BLUE ROCK 63
DIERDONK 80 1
RLUC Rask 100
Blur Rack 190 11
BLOT BOSK 140
Rock IES 1
New States
Say It clause 100
Sand IVO
San 200
5 mal 220
Ra-11 294

Description of formations encountered must be provided for all

wells and boreholes, unless specifically exempted by regulations

If more than one screen, show location of each on sketch

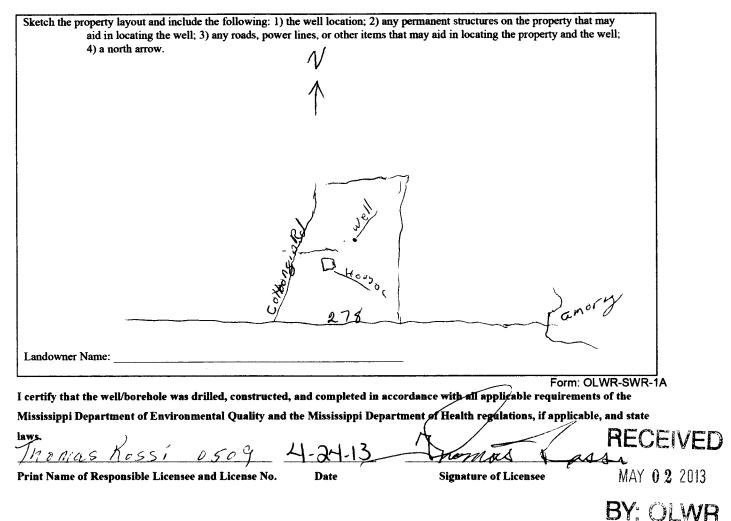

	STATE WI	ELL REPORT		
County: Monroz	-	art 2 Completion Report	For Office Use Only:	
Permit #:	Pump Installer's Completion Report Mississippi Department of Environmental Quality		Aquifer:	
Driller: Thomas Rossi 0509	Office of Land and Water Resources P.O. Box 10631			
Date completed: 2 - 4 - 13	Jackson, MS 39289-0631 (601)961-5210		Well #: ( 2 )	
Copy information from block on Part 1	,	4-6938 (fax)	Elevation:	
This part of the report must be completed b				
report must be attached and both parts file. Well Owner Informati			iys of well completion. Location	
Owner Name: Martha DA	1-Ymple	Latitude: 33-59-07 Longitude: 88-31-40		
Mailing Address: <u>POB 6 x 2/0</u>		Method of Lat/Long (check one): Conventional Survey		
		USGS quad, Hand-held	GPS, Survey-grade GPS	
Amory MS City State	<u>3687</u> Zip Code	<u>S</u> <sup>1</sup> / <sub>4</sub> <sup>1</sup> / <sub>4</sub> Sec <u>2</u> 7 T <u>1</u> S <u>R</u> <u>7</u> <u>E</u> 1/2 1/2 Distance Direction Nearest Town 191V		
THE MILLART S		Distance Direction Nearest Town $\frac{3}{Miles} \frac{WCS}{Miles} of \frac{a_{mory}}{Miles}$		
Telephone No. (662 256 - 3.5	<u> </u>	$- \underline{\mathbf{u}}_{\text{Miles}} \underline{\mathbf{w}} \underline{\mathbf{v}} \underline{\mathbf{v}}_{\text{Miles}} \mathbf{v}_{\text{Miles}}$		
Pump Type		Pov	ver Type	
Circle one		Ci	rcle one	
Air Lift Jet	Submersible	Diesel Engine Gasoline	e Engine Natural Gas	
Bucket Piston	Turbine	Electric Motor Hand	Tractor PTO	
Centrifugal Rotary	Flowing Well	Windmill Other (s	specify):	
Other (specify):		Horse Power Rating of Motor:	1 HP	
Date Pump Installed:		Setting Depth: <u>207</u>	feet	
Rated Pump Capacity:	Gallons Per Minute	Number of Stages: <u>/ 8</u>		
Pump Test Data		Method of Mea	suring Water Level	
Date Well Tested:		Cir	rcle one	
Static Water Level (A): <u>1.5 ()</u> Feet Below Land Surface		Air Line Electric Meas	uring Line Steel Tape	
Pumping Water Level (B): $(1)$ Feet Below Land Surface		Other (specify):		
( )	Below Land Surface	For flowing well measured shi	ut in head: feet	
-	Gallons Per Minute	For flowing well, measured shut in head:feet Well yielded GPM with a drawdown of		
Duration of Pump Test (minimum 4 hours):		feet after hours of pumping		
		6		
I HEREBY CERTIFY that the above stateme Thomas Bassi DS		i my knowledge.	RECEIV	
Print Name of Pump Installer and License No		Signature of Pump Ins	taller	
	-		Form: OLWR HAVR-002 20	

. ب