

Monroe
C 2001
6-4-76

MISSISSIPPI
BOARD OF WATER COMMISSIONERS
416 North State Street
13B Jackson, Mississippi 39201

WATER WELL DRILLERS LOG

6-4-1976 date well completed W.J. REEVES & SON firm name MONROE county well located

LANDOWNER: L. D. EADS
RT. 2
AMORY
(mailing address)

description of formations encountered	from	to
	RED CLAY	0
RED SAND	22	80
BLUE CLAY	80	81

WELL LOCATION:
sec. 23 T 12 N R 1 E S 4
4 miles E of AMORY
(distance) (direction) (nearest town)

WELL PURPOSE: HOME
(home, irrigation, municipal, industrial)

WELL COMPLETION DATA:

(1) diameter (inches) 4

(2) total depth (feet) 81

(3) static water level (feet) 28 below above top of ground.

(4) casing PVC 61
(material) (depth)
4 (size) if telescope see back.

(5) screen 20 61
(length) (depth to top)
4 PVC
(size) (material)

(6) pump 1/2 7
(HP) (yield gpm)
ELECT (type power)

(7) electric log NO
(yes or no)

(organization running log)

(8) how well bottom plugged SAND


RECEIVED
APR 12 1977

DRILLERS REMARKS:

MISS. BD. OF WATER COMMISSIONERS

If well telescopes please sketch and show depths.

GROUND LEVEL

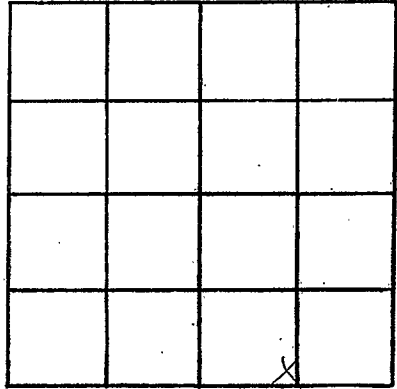

SECTION 23

Please indicate well location X.

ADDITIONAL INFORMATION

If more than one screen,
show locations of each on sketch.