

MONROE

C 2004

9-12-78

MISSISSIPPI
 BOARD OF WATER COMMISSIONERS
 416 North State Street
 Jackson, Mississippi 39201

WATER WELL DRILLERS LOG

Sept. 12 1978 Mid-South Drilling Monroe
 date well completed firm name county well located


LANDOWNER: <u>Kelly Umphrees</u>	description of formations encountered	from	to
<u>Rt. 3</u>			
<u>Watley MS</u> (mailing address)	<u>sand</u>	<u>0</u>	<u>15</u>
	<u>clay & sand</u>	<u>15</u>	<u>30</u>
	<u>rock at 25</u>		
	<u>clay & sand</u>	<u>30</u>	<u>45</u>
	<u>sand</u>	<u>45</u>	<u>54</u>
	<u>clay</u>	<u>54</u>	<u>90</u>
	<u>clay & sand</u>	<u>90</u>	<u>120</u>
	<u>rock at 113"</u>		
	<u>clay</u>	<u>120</u>	<u>140</u>
	<u>clay & sand</u>	<u>140</u>	<u>165</u>
	<u>clay</u>	<u>165</u>	<u>175</u>
	<u>sand</u>	<u>175</u>	<u>206</u>
WELL LOCATION:			
sec. <u>25</u> T. <u>12</u> N. R. <u>11</u> E. S. <u>5</u>			
<u>5</u> miles <u>E</u> of <u>Watley</u>			
(distance) (direction) (nearest town)			
WELL PURPOSE: (home, irrigation, municipal, industrial)			
WELL COMPLETION DATA:			
(1) diameter (inches) <u>4</u>			
(2) total depth (feet) <u>206</u>			
(3) static water level (feet) <u>140</u> below above top of ground.			
(4) casing <u>PVC</u> , <u>186</u> (material) (depth)			
(size) If telescope see back.			
(5) screen <u>20</u> , <u>186</u> (length) (depth to top)			
<u>10 1/2"</u> , <u>PVC</u> (size) (material)			
(6) pump <u>1</u> , <u>9</u> (HP) (yield gpm)			
<u>electric</u> (type power)			
(7) electric log <u>no</u> (yes or no)			
<u>no</u> (organization running log)			
(8) how well bottom plugged <u>Screen</u>			
DRILLERS REMARKS:			

RECEIVED
 NOV 16 1978

MISS. BD. OF WATER COMMISSIONERS

If well telescopes please sketch and show depths.

GROUND LEVEL

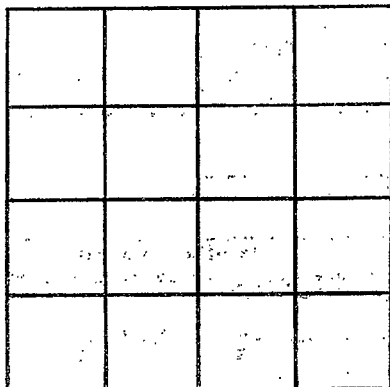

SECTION _____

Please indicate well location: X.

ADDITIONAL INFORMATION

If more than one screen, show locations of each on sketch.