

MISSISSIPPI DEPARTMENT OF NATURAL RESOURCES
Bureau of Land and Water Resources

P.O. Box 10631

Jackson, Mississippi 39209
WATER WELL DRILLERS LOG

COUNTY WELL LOCATED Montroe	
WELL NUMBER C 2008	CODED
DATE WELL COMPLETED 6-13-89	

PERMIT NUMBER
NAME OF DRILLING FIRM Rossi Drilling

NAME & MAILING ADDRESS OF LANDOWNER Carl J. Reed			
RT 2 Amory			
WELL LOCATION: SEC	TOWNSHIP	RANGE	
	24	125	N 18 -E
DISTANCE	DIRECTION	NEAREST TOWN	
2 1/2 Miles	North	Bigbee	
OTHER LANDMARK Heaster Road			
WELL PURPOSE: Home, Irrigation, Municipal, Industrial, Fish Pond, etc.			

PUMP DATA		
PUMP TYPE (Circle One): <u>Submersible</u> , Turbine, Jet, Flowing Well, Other (Describe) _____		
POWER TYPE (Circle One): <u>Electric</u> , Tractor, Diesel, Gasoline, Butane, Other (Describe) _____ H/P _____		
Pump Capacity (GPM) 122 GPM	No. of Stages	Setting Depth 126' FT.
PUMP TEST Well yielded _____ GPM with a drawdown of _____ ft. after _____ hours of pumping		

WELL DATA		
Well Depth 125'	Casing Diameter (In.) 4	Casing Length (Ft.) 125'
Type of Casing PVC	Hole Depth 90'	Depth to Static Water Level
TYPE OF COMPLETION: (Circle One or More): <input checked="" type="checkbox"/> Gravel Packed, <input type="checkbox"/> Underreamed, <input type="checkbox"/> Telescoped, <input type="checkbox"/> Natural Development, <input type="checkbox"/> Open Hole, <input type="checkbox"/> Other (Describe) _____		
Top of Lap Pipe or Reduction in Casing FEET IF TELESCOPED OR MORE THAN ONE SCREEN: USE BACK PAGE		

LOG DATA	
TYPE OF LOG RUN (Circle One): <u>No Log Run</u> , Electric, Gamma Ray, Density, Sonic, Neutron, Other (Describe) NO LOG	
Name of Organization Running Log	

SCREEN DATA		
Diameter - Inches 4"	Length - Feet 10'	Slot Size - Inches .013
Screen Type Slotted	Depth to Bottom - Feet 135'	


GEOLOGIC DATA (Office Use Only)			
Surface Elev.	Geologic Unit	Unit Thickness	Depth to Top
Subs. SWL	Date	Analysis	Aquifer Test
Driller's Remarks			

DESCRIPTION OF FORMATIONS ENCOUNTERED	FROM	TO	FORMATIONS (Continued)	FROM	TO
Red Clay	0	36'	RECEIVED MAY 14 1990 Department of Natural Resources Bureau of Land & Water Resources		
Sand	35	74			
Clay	74	90			
Sand & Clay "Broken"	90	130			
Water Sand	120	135			

IF MORE SPACE IS NEEDED, USE BACK

If well telescopes please sketch and show depths.

GROUND LEVEL

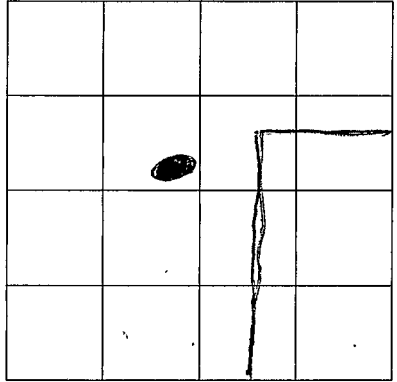

SECTION 24S

Please indicate well location X.

ADDITIONAL INFORMATION

If more than one screen,
show location of each on sketch.