

MONROE
0
4-67

MISSISSIPPI
 BOARD OF WATER COMMISSIONERS
 416 North State Street
 Jackson, Mississippi 39201

WATER WELL DRILLERS LOG

4-9 1967 W. J. REEVES & SON MONROE
 date well completed firm name county well located

LANDOWNER: C. W. FAULKNER

RT. 1

GREENWOOD SPRINGS
 (mailing address)

WELL LOCATION: 17 W
 sec. 36 T 12 S R. 15 E
10 miles E of AMORY
 (distance) (direction) (nearest town)

WELL PURPOSE: HOME
 (home, irrigation, municipal, industrial)

WELL COMPLETION DATA:


- (1) diameter (inches) 4
- (2) total depth (feet) 146
- (3) static water level (feet) 92 below
top of ground.
- (4) casing PVC, 126
(material) (depth)
4
(size) if telescope see back.
- (5) screen 20', 126
(length) (depth to top)
4", PVC
(size) (material)
- (6) pump 3/4, 10
(HP) (yield gpm)
ELECT
(type power)
- (7) electric log No
(yes or no)

(organization running log)
- (8) how well bottom plugged SAND

description of formations encountered

from to


RED CLAY	0	9
CLAY & GRAVEL	9	15
BLACK CLAY	15	57
BLUE CLAY	57	122
SAND & GRAVEL	122	146

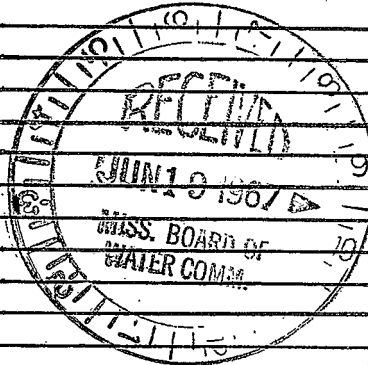

DRILLERS REMARKS:

If well telescopes please sketch and show depths.

GROUND LEVEL

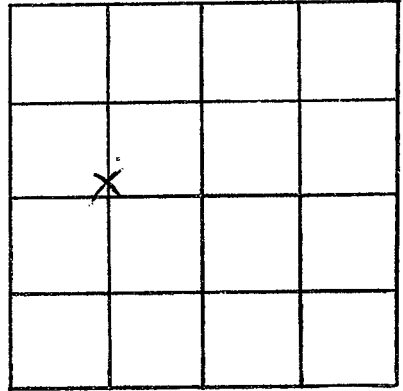

SECTION _____

Please indicate well location X.

ADDITIONAL INFORMATION

If more than one screen, show locations of each on sketch.