

MONROE

MISSISSIPPI BOARD OF WATER COMMISSIONERS

D 5
6-7-61

WATER WELL DRILLERS LOG

~~D-303~~
D5
D-301

CODED

Date: June 7, 1961, Driller: Layne-Central Co. County Monroe

(Name)

(1) Owner of Land: Town of Smithville
 (Name)
Smithville, Mississippi
 (Address)

(2) Location: NW 5E NW 1/4, Sec. 6 T12S 9E
 (distance) miles _____ of _____ (Nearest Town)
 (direction)

(3) Topography: _____
 (Hilly) (Flat) (Level)

(4) Purpose of Well: Municipal
 (Domestic Irrigation
 Municipal, Industrial, Other)

| Description & Color of Materials Sand, Clay, Red Clay, Shell, etc. | Thick- ness Feet | Depth Feet |
|---|------------------------|---------------|
| sandy clay | 13 | 13 |
| sand and gravel | 5 | 18 |
| sandy clay, stks sand | 28 | 46 |
| sand | 4 | 50 |
| clay | 34 | 84 |
| sand | 26 | 110 |
| sand | 22 | 132 |
| sand | 4 | 136 |
| rock | 2 | 138 |
| hard coarse sand & shells | 16 | 154 |
| " " " " | 6 | 160 |
| hard cemented sand | 1 | 161 |
| hard coarse sand-shells | 8 | 179 |
| rock | 7 | 186 |

Information upon completion of well:

(1) Diameter 8" inches.

(2) Total Depth 178'7" feet.

(3) Water Level 10' feet below top of ground.

(4) Cased to 153', Size 8"


(5) Screen: Size 6", Length 20'2"

(6) Were any formations sealed against pollution?
 yes, no.

If YES depth of formation 153'
 Why Required

Drillers Remarks:

CODED

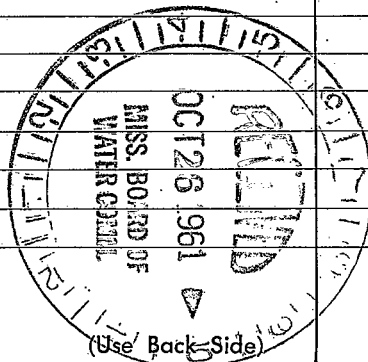

(Use Back Side)

Well No.

(+)