

CODED

CODED

CODED

CODED

MONROE

D 9

10-11-68

MISSISSIPPI
 BOARD OF WATER COMMISSIONERS
 416 North State Street
 Jackson, Mississippi 39201

WATER WELL DRILLERS LOG

10-11-1968 date well completed W.J. REEVES & SON firm name MONROE county well located

LANDOWNER: W.A. GIDEON

GREENWOOD SPRINGS,

MISS-

(mailing address)

description of formations encountered

from

to

| | | |
|---------------|----|-----|
| RED CLAY | 0 | 19 |
| RED SAND | 19 | 24 |
| BLACK CLAY | 24 | 85 |
| SAND & GRAVEL | 85 | 144 |

WELL LOCATION:

sec. 36 T. 12 S. R. 12 E. S. 17
 10 miles E of AMORY
 (distance) (direction) (nearest town)

WELL PURPOSE: HOME
 (home, irrigation, municipal, industrial)

WELL COMPLETION DATA:

- (1) diameter (inches) 4
- (2) total depth (feet) 144
- (3) static water level (feet) 84 below top of ground.
- (4) casing PVC, 144 (material), (depth)
- 4 (size) if telescope see back.
- (5) screen 20' (length), 122' (depth to top)
- 4 (size), PVC (material)
- (6) pump 3/4 (HP), 12 (yield gpm)
- ELECT (type power)
- (7) electric log No (yes or no)

(organization running log)

(8) how well bottom plugged SAND


DRILLERS REMARKS:

JAN 10 1969

MISS. Bd. of WATER COMMISSIONERS

If well telescopes please sketch and show depths.

GROUND LEVEL

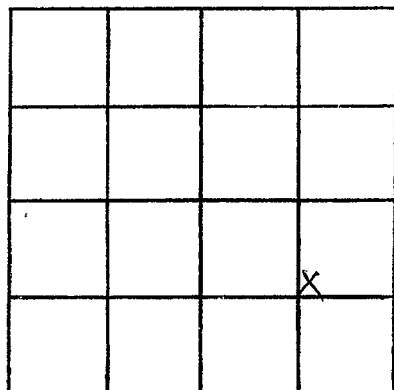

SECTION 36

Please indicate well location X.

ADDITIONAL INFORMATION

If more than one screen, show locations of each on sketch.