

CODED
CODED
CODED
CODED

Monroe
D 11
11-4-68

MISSISSIPPI
BOARD OF WATER COMMISSIONERS
416 North State Street
Jackson, Mississippi 39201
WATER WELL DRILLERS LOG

11-4 date well completed 1968 J. W. J. REEVES & SON firm name MONROE county well located

LANDOWNER: B. T. CHEER
SMITHVILLE, MISS.

description of formations encountered	from	to
RED CLAY	0	20
SAND & GRAVEL	20	27
BLUE CLAY	27	82
" SAND	82	91
" CLAY	91	102
" SAND	102	133

(mailing address)

WELL LOCATION:
sec. 6 T. 11 R. 9 E
S #
1 miles S of SMITHVILLE
(distance) (direction) (nearest town)

WELL PURPOSE: HOME
(home, irrigation, municipal, industrial)

- WELL COMPLETION DATA:
- (1) diameter (inches) 4
 - (2) total depth (feet) 133
 - (3) static water level (feet) 38 below top of ground.
 - (4) casing PVC 133 (material) (depth)
4 (size) if telescope see back.
 - (5) screen 20' 111' (length) (depth to top)
4 PVC (size) (material)
 - (6) pump 1 20 (HP) (yield gpm)
ELECT (type power)
 - (7) electric log NO (yes or no)
- (organization running log)

(8) how well bottom plugged SAND


DRILLERS REMARKS:

JAN 10 1968

MISSISSIPPI BOARD OF WATER COMMISSIONERS
JANUARY 1968

If well telescopes please sketch and show depths.

GROUND LEVEL

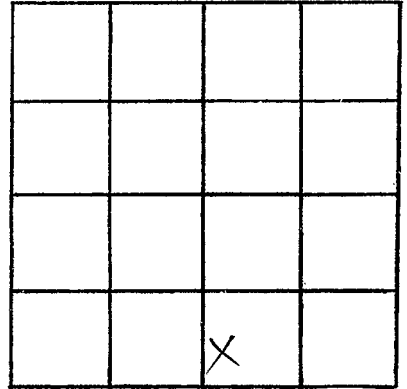

SECTION 6

Please indicate well location X.

ADDITIONAL INFORMATION

If more than one screen, show locations of each on sketch.