

CODED

MISSISSIPPI  
BOARD OF WATER COMMISSIONERS  
416 North State Street  
Jackson, Mississippi 39201

WATER WELL DRILLERS LOG

MONROE  
D 12  
2-19-69

2-19 1969 W. J. REEVES & SON MONROE  
date well completed firm name county well located

LANDOWNER: RICHARD COLE

description of formations encountered

from to

BT. 2  
Amory  
(mailing address)

RED CLAY	0	16
WHITE SAND	16	24
YELLOW CLAY	24	27
RED SAND	27	38
BLUE CLAY	38	43
" SAND	43	58
" CLAY	58	171
WHITE SAND	171	197
BLUE CLAY	197	200

WELL LOCATION:

sec. 19 T 12 S R 9 E  
6 miles EAST of Amory  
(distance) (direction) (nearest town)

WELL PURPOSE: HOC PARLOR  
(home, irrigation, municipal, industrial)

WELL COMPLETION DATA:

- (1) diameter (inches) 4
- (2) total depth (feet) 200
- (3) static water level (feet) 116 below top of ground
- (4) casing PVC 180 (material) (depth)  
4 (size) If telescope see back.
- (5) screen 20 180 (length) (depth to top)  
4 PVC (size) (material)
- (6) pump 1/2 25 (HP) (yield gpm)
- ELECT. (type power)
- (7) electric log NO (yes or no)  
(organization running log)
- (8) how well bottom plugged SAND


JUN 23 1969

MISS. DE. OF WATER CONTROL

DRILLERS REMARKS:

If well telescopes please sketch and show depths.

GROUND LEVEL

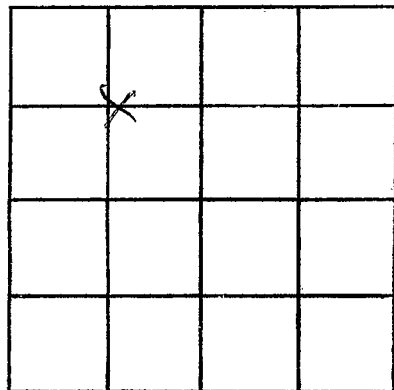

SECTION 19

Please indicate well location X.

ADDITIONAL INFORMATION

If more than one screen, show locations of each on sketch.