

CODED

MISSISSIPPI BOARD OF WATER COMMISSIONERS
416 North State Street
Jackson, Mississippi 39201

WATER WELL DRILLERS LOG

MONROE
D 14
3-13-69

3-13 1969 W. J. REEVES & SON MONROE
date well completed firm name county well located

LANDOWNER: J. D. PARHAM

description of formations encountered	from	to
	RED CLAY	0
" SAND	15	64
RED SAND + CLAY STRKS	64	99
BLUE CLAY	99	102

RT. 2

AMORY
(mailing address)

WELL LOCATION:
sec. 19 T. 12 S. R. 9 E
6 miles E of AMORY
(distance) (direction) (nearest town)

WELL PURPOSE: HOME
(home, irrigation, municipal, industrial)

WELL COMPLETION DATA:

- (1) diameter (inches) 4
- (2) total depth (feet) 102
- (3) static water level (feet) 40 below top of ground.
- (4) casing PVC, 67 (material) (depth)
4 (size) if telescope see back.
- (5) screen 35, 67 (length) (depth to top)
4, PVC (size) (material)
- (6) pump 1/2, 10 (HP) (yield gpm)
ELECT (type power)
- (7) electric log NO (yes or no)
- (organization running log)
- (8) how well bottom plugged SAND


DRILLERS REMARKS:

JUN 23 1969



If well telescopes please sketch and show depths.

GROUND LEVEL

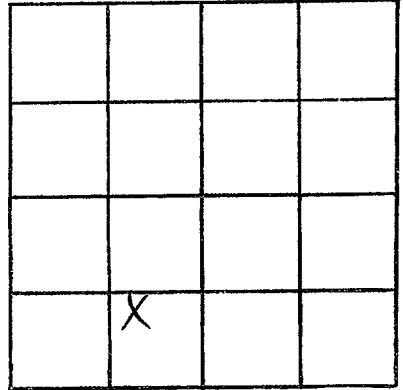

SECTION 19

Please indicate well location X.

ADDITIONAL INFORMATION

If more than one screen, show locations of each on sketch.