

MONROE
D 15
6-27-69

MISSISSIPPI
BOARD OF WATER COMMISSIONERS
416 North State Street
Jackson, Mississippi 39201

WATER WELL DRILLERS LOG

6-27 1969 W. J. REEVES & SON MONROE
date well completed firm name county well located

LANDOWNER: C. W. JOHNSON

1220 BROWN ST.

AMERY

(mailing address)

WELL LOCATION:

sec. 3 T. 11 S. R. 9 E.
3 miles E of SMITHVILLE
(distance) (direction) (nearest town)

WELL PURPOSE: STOCK
(home, irrigation, municipal, industrial)

WELL COMPLETION DATA:

- (1) diameter (inches) 4
- (2) total depth (feet) 146
- (3) static water level (feet) 84 below top of ground.
- (4) casing PVC, 126,
(material) (depth)
4 if telescope see back.
(size)
- (5) screen 20, 126
(length) (depth to top)
4, PVC
(size) (material)
- (6) pump 1, 15
(HP) (yield gpm)
ELECT
(type power)
- (7) electric log NO
(yes or no)

(organization running log)
- (8) how well bottom plugged SAND

description of formations encountered

from to

CLAY	0	8
CLAY & GRAVEL	8	20
SAND & "	20	38
BLUE CLAY	38	70
GRAY SAND	70	82
BLUE CLAY + SAND	82	104
" "	104	122
GRAY SAND	122	132
SAND & GRAVEL	132	141
BLUE CLAY	141	146


DRILLERS REMARKS:

MISS. RD. OF
WATER COMM.

AUG 18 1969

If well telescopes please sketch and show depths.

GROUND LEVEL

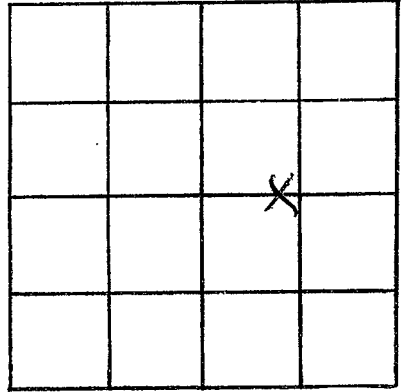

SECTION 3

Please indicate well location X.

ADDITIONAL INFORMATION

If more than one screen, show locations of each on sketch.