

MONROE
D16
3-11-70

MISSISSIPPI
BOARD OF WATER COMMISSIONERS
416 North State Street
Jackson, Mississippi 39201

CODED

WATER WELL DRILLERS LOG

3-11 1970 W. J. REEVES & SON MONROE
date well completed firm name county well located

LANDOWNER: L. D. HURLEY
RT. I

description of formations encountered	from	to
	RED CLAY	0
RED SAND & CLAY	24	106

SMITHVILLE
(mailing address)

WELL LOCATION:

sec. 20 T 12 S R 9 E
4 miles SE of SMITHVILLE
(distance) (direction) (nearest town)

WELL PURPOSE: HOME
(home, irrigation, municipal, industrial)

WELL COMPLETION DATA:

- (1) diameter (inches) 4
- (2) total depth (feet) 106
- (3) static water level (feet) 73 below top of ground above
- (4) casing PVC 86 (material) (depth)
4 (size) if telescope see back.
- (5) screen 20 86 (length) (depth to top)
4 PVC (size) (material)
- (6) pump (HP) (yield gpm)
(type power)
- (7) electric log NO (yes or no)
(organization running log)

CODED

AUG 26 1970


(8) how well bottom plugged SAND

DRILLERS REMARKS:

MISS. Bd. of
WATER COMMISSIONERS

If well telescopes please sketch and show depths.

GROUND LEVEL

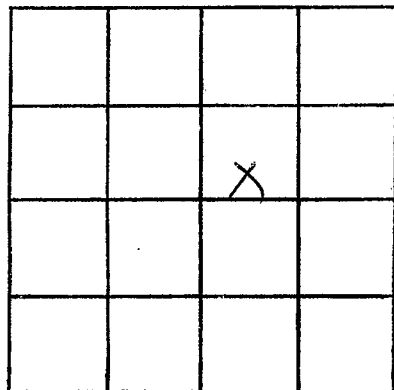

SECTION 20

Please indicate well location X.

ADDITIONAL INFORMATION

If more than one screen, show locations of each on sketch.