

MONROE
D17
2-22-71

MISSISSIPPI
BOARD OF WATER COMMISSIONERS
416 North State Street
Jackson, Mississippi 39201

CODED

WATER WELL DRILLERS LOG

2-22 1971 W.J. REEVES & SON MONROE
date well completed firm name county well located

LANDOWNER: CW. MATTOX

description of formations encountered

from

to

Rt. 2
Amory
(mailing address)

RED CLAY 0 20
RED CLAY & SAND 20 82
BLUE CLAY 82 260
SAND & GRAVEL 260 295

WELL LOCATION:

sec. 20 T 12 S R. 9 E
9 miles E of Amory
(distance) (direction) (nearest town)

WELL PURPOSE: HOME
(home, irrigation, municipal, industrial)

WELL COMPLETION DATA:

- (1) diameter (inches) 4
- (2) total depth (feet) 295
- (3) static water level (feet) 210 below above top of ground.
- (4) casing PVC, 275
(material) (depth)
4 if telescope see back.
(size)
- (5) screen 20', 275
(length) (depth to top)
4", PVC
(size) (material)
- (6) pump 1, 10
(HP) (yield gpm)
ELECT
(type power)

CODED

(7) electric log NO
(yes or no)

(organization running log)

(8) how well bottom plugged SAND


MAR 16 1971

MISS. BD. OF
WATER COMM.

DRILLERS REMARKS:

If well telescopes please sketch and show depths.

GROUND LEVEL

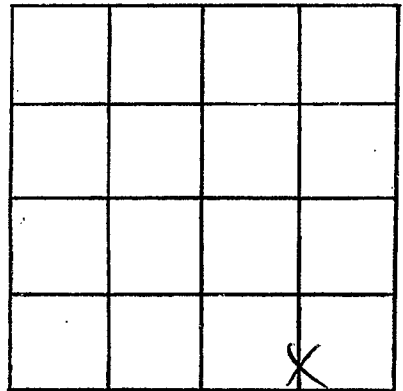

SECTION 20

Please indicate well location X.

ADDITIONAL INFORMATION

If more than one screen, show locations of each on sketch.