

D18

D 300

8-23-60

WATER WELL DRILLERS LOG

CODED

Date: 8-23, 19 60, Driller: W.J. REEVES 2000 County MONROE

382-2 CROSS BR LAST WH NO ON L (Name)

(1) Owner of Land:	Description & Color of Materials Sand, Clay, Red Clay, Shell, etc.	Thick- ness Feet	Depth Feet
CURTIS KENDRICK (Name)	BLUE CLAY	8	0
SMITHVILLE, MISS (Address)	GRAVEL	7	8
6514303	SANDY CLAY	9	15
(2) Location: SE 1/4, SW 1/4, Sec. 6 T12R9	BLUE CLAY	30	24
2 miles E of SMITHVILLE (distance) (direction) (Nearest Town)	WHITE SAND	15	54
(3) Topography: LEVEL (Hilly) (Flat) (Level)			
(4) Purpose of Well: DOMESTIC (Domestic Irrigation Municipal, Industrial, Other)			

Information upon completion of well:

(1) Diameter 4 x 2 1/2 inches.

(2) Total Depth 69 feet.

(3) Water Level 10 feet below top of ground.

(4) Cased to 38 1/2', Size 2 1/2"

(5) Screen: Size 2 1/2", Length 5'


(6) Were any formations sealed against pollution?
 _____ yes, _____ no.

CODED

If YES depth of formation _____

Why _____

Drillers Remarks: _____

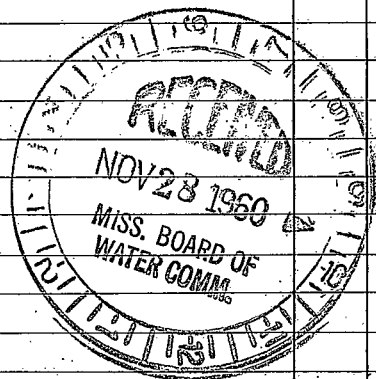

(Use Back Side)

Well No.

