

MISSISSIPPI
BOARD OF WATER COMMISSIONERS
416 North State Street
Jackson, Mississippi 39201

CODED

WATER WELL DRILLERS LOG

MONROE
D20
3-67

3-11 1967 W.J. REEVES LSON MONROE
date well completed firm name county well located

LANDOWNER: J.A. HURLEY

description of formations encountered

from to

RT. 2 OLD COTTON GIN RD.
256 8914

RED CLAY 0 18
" SAND 18 57
BLUE CLAY 57 215
SAND & GRAVEL 215 262

Amory
(mailing address)

WELL LOCATION: 17W
sec 29 T. 12 R. 2
Plotted on Co. map.
7 miles E of AMORY
(distance) (direction) (nearest town)

WELL PURPOSE: HOME
(home, irrigation, municipal, industrial)

WELL COMPLETION DATA:

- (1) diameter (inches) 4
(2) total depth (feet) 261 1/2
(3) static water level (feet) 150 below top of ground.
(4) casing PVC, 261 1/2 (material) (depth)

CODED


- (size) If telescope see back.
(5) screen 20', 240 (length) (depth to top)
4, PVC (size) (material)

- (6) pump NONE (HP) (yield gpm)
(type power)

- (7) electric log No (yes or no)

(organization running log)

- (8) how well bottom plugged SAND

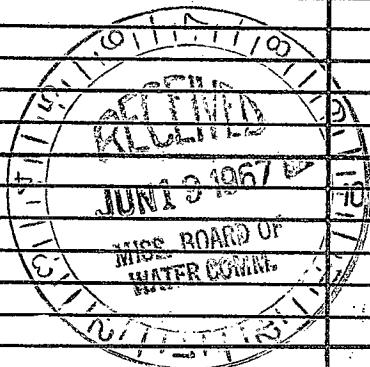


DRILLERS REMARKS:

9 1/2" DRILL HOLE
GRAVEL PACKED

If well telescopes please sketch and show depths.

GROUND LEVEL

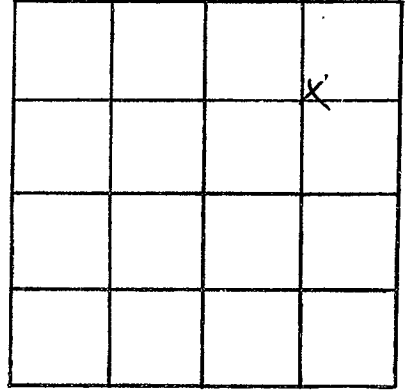

SECTION 29

Please indicate well location X.

ADDITIONAL INFORMATION

If more than one screen,
show locations of each on sketch.