

~~WD21~~ D21

6-13-61

WATER WELL DRILLERS LOG

CODED

Date: 6-13, 1961, Driller: J.C. REEVES County MONROE

490-491-492-493-494 629, 956, 1049 (Name) J.C. REEVES MON. TR. & MAN. IN S.M.

Amory Gannett Co. TROUSERS PLANT
 (1) Owner of Land: T. J. LONGENECKER

Description & Color of Materials
 Sand, Clay, Red Clay, Shell, etc.

SMITHVILLE (Name)
AMORY, MISS- (Address)

CLAY 17 0
RED SAND 71 17

940005, 256 5733
 (2) Location: SE 1/4, NW 1/4, Sec. 6 T12R9E

5 miles NORTH, of AMORY
 (distance) (direction) (Nearest Town)

(3) Topography: HILLY
 (Hilly) (Flat) (Level)

(4) Purpose of Well: DOMESTIC
 (Domestic Irrigation
 Municipal, Industrial, Other)

Information upon completion of well:

(1) Diameter: 4 inches.

(2) Total Depth: 88 feet.

(3) Water Level: 50 feet below top of ground.

(4) Cased to: 78', Size: 4"

(5) Screen: Size: 4", Length: 10'


(6) Were any formations sealed against pollution?
 _____ yes, _____ no.

If YES depth of formation _____

Why _____

Drillers Remarks: _____

CODED

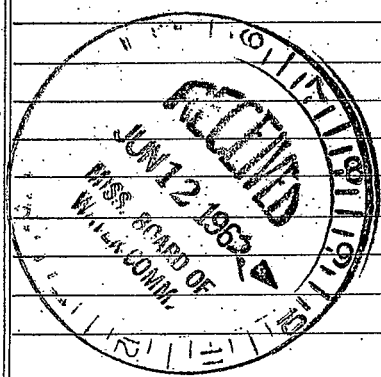

(Use Back Side)

Well No.

THE HISTORY OF THE

Faint, illegible text covering the majority of the page, appearing to be a historical document or manuscript.