

MONROE
D25
7-7-72

MISSISSIPPI
BOARD OF WATER COMMISSIONERS
416 North State Street
Jackson, Mississippi 39201

CODED

WATER WELL DRILLERS LOG

7-7 1972 W. J. REEVES & SON MONROE
date well completed firm name county well located

LANDOWNER: NEW HOPE BAPTIST CHURCH

description of formations encountered	from	to
RED CLAY	0	22
RED SD CLAY STKS	22	95
BLUE CLAY	93	95

RT. 2
AMORY
(mailing address)

WELL LOCATION:
sec. 20 T 12 R 17W S
7 miles E of AMORY
(distance) (direction) (nearest town)

WELL PURPOSE: HOME
(home, irrigation, municipal, industrial)

- WELL COMPLETION DATA:
- (1) diameter (inches) 4
 - (2) total depth (feet) 95
 - (3) static water level (feet) 70 below top of ground.
 - (4) casing PVC, 75 (depth), 4 (size) if telescope see back.
 - (5) screen 20 (length), 75 (depth to top), 4 (size), PVC (material)
 - (6) pump 1 (HP), 5 (yield gpm), ELECT (type power)
 - (7) electric log No (yes or no)
 - (organization running log)
 - (8) how well bottom plugged SAND

CODED


NOV 14 1972

DRILLERS REMARKS:

MISS. BD. OF WATER COM.

If well telescopes please sketch and show depths.

GROUND LEVEL

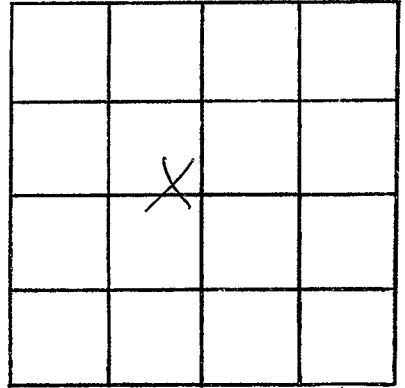

SECTION 20

Please indicate well location X.

ADDITIONAL INFORMATION

If more than one screen,
show locations of each on sketch.