

MONROE
D26
1-27-75

MISSISSIPPI
BOARD OF WATER COMMISSIONERS
416 North State Street
Jackson, Mississippi 39201

CODED

WATER WELL DRILLERS LOG

1-27 1975 W. J. REEVES & SON MONROE
date well completed firm name county well located

LANDOWNER: QUINCY WATER ASSN.
GREENWOOD SPRINGS
(mailing address)

description of formations encountered	from	to
	CLAY	0
SAND & GRAVEL	17	115

WELL LOCATION:
sec. 36 T. 12 N. R. 4 E. 34 W.
S
1 miles N of SPUNGE
(distance) (direction) (nearest town)

WELL PURPOSE: MUN.
(home, irrigation, municipal, industrial)

WELL COMPLETION DATA:

(1) diameter (inches) 6

(2) total depth (feet) 115

(3) static water level (feet) 24 below top of ground.

(4) casing PVC, 95, (material) (depth)
6 (size) if telescope see back.

(5) screen 20, 95 (length) (depth to top)
4, STAINLESS STEEL (size) (material)

(6) pump 3, 70 (HP) (yield gpm)
EJECT (type power)

(7) electric log NO (yes or no)

(organization running log)

(8) how well bottom plugged VALUE

DRILLERS REMARKS:

CODED


INDEXED
MAR 17 1975

MISS. BD. OF WATER COMMISSIONERS

(Y)

If well telescopes please sketch and show depths.

GROUND LEVEL

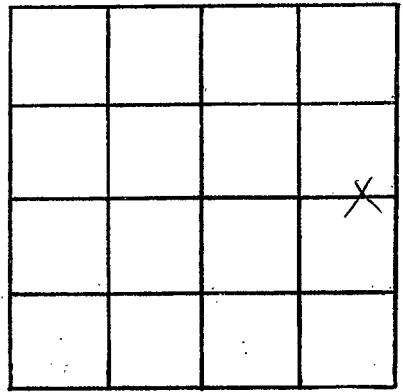

SECTION 36

Please indicate well location X.

ADDITIONAL INFORMATION

A series of horizontal lines for writing additional information, starting below the 'ADDITIONAL INFORMATION' header and extending down to the bottom of the page.

If more than one screen, show locations of each on sketch.