

MONROE
D 200
2-67

MISSISSIPPI
BOARD OF WATER COMMISSIONERS
416 North State Street
Jackson, Mississippi 39201

WATER WELL DRILLERS LOG

2-24 1967 W.J. REEVES & SON MONROE
date well completed firm name county well located

LANDOWNER: EDVIN FAULKNER

description of formations encountered from to

GREENWOOD SPRINGS
(mailing address)


RED CLAY	0	14
BLACK GUMBO	14	37
RED SAND	37	70
SAND & GRAVEL	70	110

WELL LOCATION: 17 W
sec. 36 T. 12 S R. E #
11 miles E of AMORY
(distance) (direction) (nearest town)

WELL PURPOSE: HOME
(home, irrigation, municipal, industrial)

WELL COMPLETION DATA:

- (1) diameter (inches) 4
- (2) total depth (feet) 110'
- (3) static water level (feet) 60 below top of ground.
- (4) casing PVC, 110' (material) (depth)
- (size) if telescope see back.
- (5) screen 20', 88' (length) (depth to top)
- 4" PVC (size) (material)
- (6) pump 3/4 HP, 10 (yield gpm)
- ELECT. (type power)
- (7) electric log NO (yes or no)
- (organization running log)
- (8) how well bottom plugged SAND

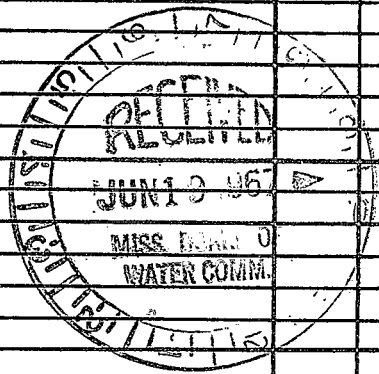

DRILLERS REMARKS:
9 1/2" DRILL HOLE
GRAVEL PACKED

If well telescopes please sketch and show depths.

GROUND LEVEL

			X

SECTION 36

Please indicate well location X.

ADDITIONAL INFORMATION

If more than one screen, show locations of each on sketch.