

Monroe
D 2001
6-69

MISSISSIPPI
BOARD OF WATER COMMISSIONERS
416 North State Street
Jackson, Mississippi 39201

WATER WELL DRILLERS LOG

6-8 1968 W.J. REEVES & SON MONROE
date well completed firm name county well located

LANDOWNER: N. C. PARHAM

description of formations encountered from to

RT. 2
AMORY, MISS.
(mailing address)

RED CLAY	0	26
RED SAND	26	82
BLUE CLAY	82	84

WELL LOCATION:
sec 24 T. 12 S. R. 17 W. E
6 miles E of AMORY
(distance) (direction) (nearest town)

WELL PURPOSE: HOME
(home, irrigation, municipal, industrial)

WELL COMPLETION DATA:


- (1) diameter (inches) 4
- (2) total depth (feet) 84
- (3) static water level (feet) 48 below top of ground.
- (4) casing PVC, 72 (material), (depth), 4" (size) if telescope see back.
- (5) screen 12, 72 (length), (depth to top), 4, PVC (size), (material)
- (6) pump 1/2 (HP), 5 (yield gpm), ELECT (type power)
- (7) electric log No (yes or no)
- (organization running log)
- (8) how well bottom plugged SAND

NOV 24 1968
MISS. Bd. of WATER CONTROL

DRILLERS REMARKS:
9 1/2" DRILL HOLE
GRAVEL PACKED

If well telescopes please sketch and show depths.

GROUND LEVEL

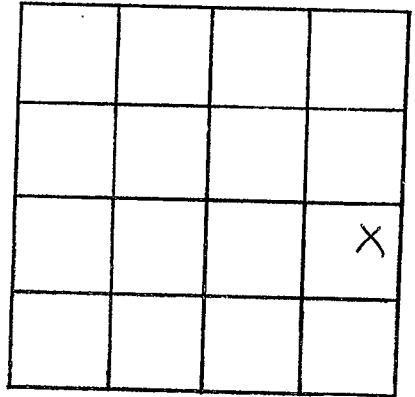

SECTION 24

Please indicate well location X.

ADDITIONAL INFORMATION

If more than one screen,
show locations of each on sketch.