




If well telescopes please sketch and show depths.

GROUND LEVEL

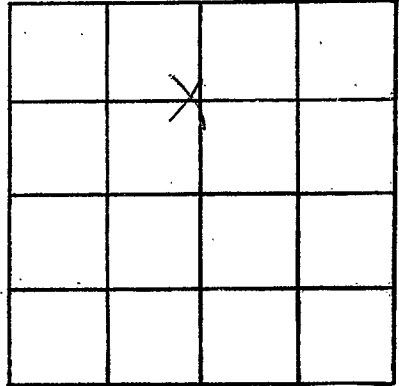

SECTION W

Please indicate well location X.

ADDITIONAL INFORMATION

If more than one screen,  
show locations of each on sketch.