

MONROE
 D 2006
 6-30-77

MISSISSIPPI
 BOARD OF WATER COMMISSIONERS
 416 North State Street
 Jackson, Mississippi 39201

WATER WELL DRILLERS LOG

6-30 1977 Mid South Drilling Co Monroe
 date well completed firm name county well located

LANDOWNER: Doug Wigginton
Smithville MS.
Route 1 Box 352
 (mailing address)

description of formations encountered	from	to
<u>Sandy clay and Rock</u>	<u>0</u>	<u>25</u>
<u>Clay</u>	<u>25</u>	<u>63</u>

WELL LOCATION:
 sec 3 T 12 N R 7 E
~~3 1/2~~ miles East of Smithville
 (distance) (direction) (nearest town)

WELL PURPOSE: Home
 (home, irrigation, municipal, industrial)

WELL COMPLETION DATA:

(1) diameter (inches) 4 in.

(2) total depth (feet) 125

(3) static water level (feet) 80 below above top of ground.

(4) casing PVC 115'
 (material) (depth)

(size) if telescope see back.

(5) screen 10' 115'
 (length) (depth to top)

4" PVC
 (size) (material)

(6) pump 1/2 650 gph
 (HP) (yield gpm)

(type power)

(7) electric log NE
 (yes or no)

(organization running log)


(8) how well bottom plugged 1 Wash
Value

DRILLERS REMARKS:

RECEIVED
 SEP 14 1977
 MISS. Bd. OF WATER COMMISSIONERS

If well telescopes please sketch and show depths.

GROUND LEVEL

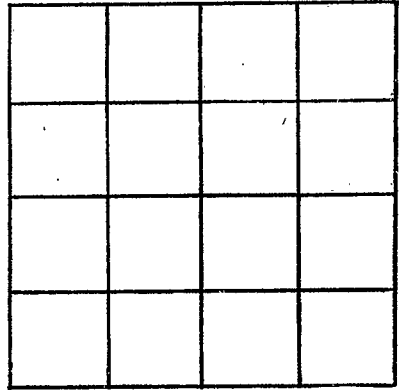

SECTION _____

Please indicate well location X.

ADDITIONAL INFORMATION

If more than one screen,
show locations of each on sketch.