

MONROE

D 2007

11-1-77

MISSISSIPPI BOARD OF WATER COMMISSIONERS
416 North State Street
Jackson, Mississippi 39201

WATER WELL DRILLERS LOG

11-1 1977
date well completed

Leiper
firm name

Monroe
county well located

LANDOWNER:

Dale Betty

Rt. 3 Amory
(mailing/address)

description of formations encountered

from

to

Red sand	0	40'
Soft clay + lignite	40'	280'
gravel	280	300

WELL LOCATION:

sec. 21 T 12 N R 9 E 17W
S W
1 1/2 miles S of Parham
(distance) (direction) (nearest town)

WELL PURPOSE: Home
(home, irrigation, municipal, industrial)

WELL COMPLETION DATA:

- (1) diameter (inches) 4
- (2) total depth (feet) 300'
- (3) static water level (feet) 240' below top of ground.
- (4) casing Plastic (material) (depth)
- (size) if telescope see back.
- (5) screen 10' (length) 290' (depth to top)
- 4" Plastic (size) (material)
- (6) pump 3/4 HP (HP) (yield gpm)
- 6 sec (type power)
- (7) electric log No (yes or no)

(organization running log)

(8) how well bottom plugged Back Wash Valve


DRILLERS REMARKS:

RECEIVED
MAY 5 1978

MISSISSIPPI BOARD OF WATER COMMISSIONERS

If well telescopes please sketch and show depths.

GROUND LEVEL

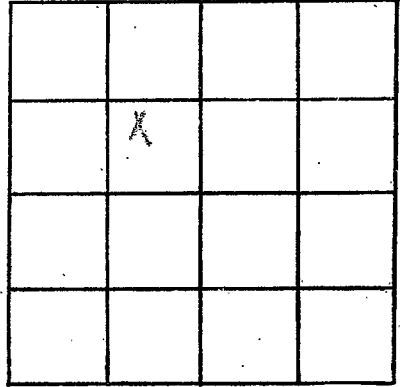

SECTION 21

Please indicate well location X.

ADDITIONAL INFORMATION

If more than one screen,
show locations of each on sketch.