

MONROE

D 2008

3-14-78

MISSISSIPPI BOARD OF WATER COMMISSIONERS  
416 North State Street  
Jackson, Mississippi 39201

WATER WELL DRILLERS LOG

3-14

1978

Leeper

Monroe

date well completed

firm name

county well located

LANDOWNER:

Mike Hanna

Rt 1 Smithville, Ms.  
(mailing address)

WELL LOCATION:

sec. 3 T. 11 N R. 9 E  
S W

4 miles SE of Smithville  
(distance) (direction) (nearest town)

WELL PURPOSE: Home  
(home, irrigation, municipal, industrial)

WELL COMPLETION DATA:

- (1) diameter (inches) 4
- (2) total depth (feet) 194
- (3) static water level (feet) below above top of ground.
- (4) casing PVC, 194, (material) (depth)
- (size) if telescope see back.
- (5) screen 10', 184 (length) (depth to top)
- 4, PVC (size) (material)
- (6) pump 1 HP, 10 (HP) (yield gpm)
- Elec. (type power)
- (7) electric log No (yes or no)

(organization running log)

(8) how well bottom plugged Back Wash Valve

DRILLERS REMARKS:

description of formations encountered

from

to


Red Sand	0	15
gravel	15	35'
Clay & Lignite	35	130'
Sand	130	158
Clay	158	160
Sand	160	194'

RECEIVED  
MAY 5 - 1978

S. BD. OF WATER COMMISSIONERS

If well telescopes please sketch and show depths.

GROUND LEVEL

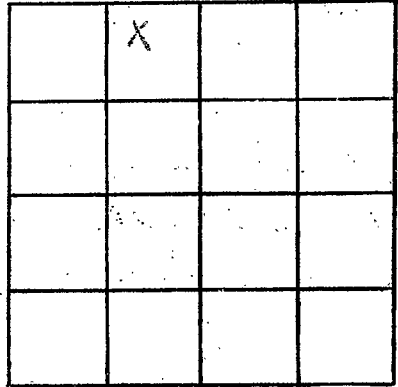

SECTION 3

Please indicate well location X.

ADDITIONAL INFORMATION

If more than one screen, show locations of each on sketch.