

MONROE
D 2009
7-18-78

**MISSISSIPPI
BOARD OF WATER COMMISSIONERS**
416 North State Street
Jackson, Mississippi 39201

WATER WELL DRILLERS LOG

7-18-1978 *Leeper* *Monroe*
 date well completed firm name county well located

LANDOWNER:
R. W. Cantrell
Smithville Ms.
 (mailing address)

description of formations encountered	from	to
	<i>Top sand & clay</i>	<i>0</i>
<i>Clay & Lignite</i>	<i>80</i>	<i>200</i>
<i>Blue clay</i>	<i>200</i>	<i>220</i>
<i>gravel</i>	<i>220</i>	<i>245</i>

WELL LOCATION:
 sec. *36* T *11* N R *9* E
8 miles *SE* of *Smithville*
 (distance) (direction) (nearest town)

WELL PURPOSE: *Home*
 (home, irrigation, municipal, industrial)

WELL COMPLETION DATA:

(1) diameter (inches) *4*

(2) total depth (feet) *245*

(3) static water level (feet) *200* below above top of ground.

(4) casing *PVC* *235*
 (material) (depth)
4 if telescope see back.
 (size)

(5) screen *10* (length) (depth to top)
4 (size) *PVC* (material)

(6) pump *3/4* (HP) *5* (yield gpm)
Elec. (type power)

(7) electric log *No.* (yes or no)

(organization running log)


(8) how well bottom plugged *Back*
wash valve

DRILLERS REMARKS:

RECEIVED
 SEP 14 1978

If well telescopes please sketch and show depths.

GROUND LEVEL

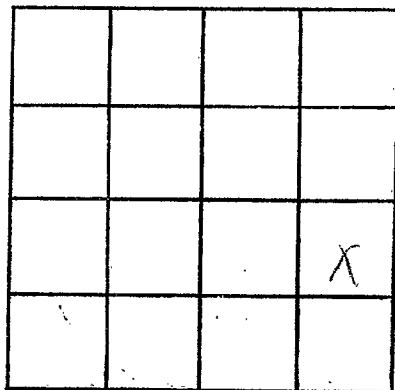

SECTION 36

Please indicate well location X.

ADDITIONAL INFORMATION

If more than one screen, show locations of each on sketch.