

MONROE

D 7010

12-15-78

MISSISSIPPI
 BOARD OF WATER COMMISSIONERS
 416 North State Street
 Jackson, Mississippi 39201

WATER WELL DRILLERS LOG

Dec 15

1978 Mid South Dwg.

Monroe

date well completed

firm name

county well located

LANDOWNER: Bill Stevenson

description of formations encountered

from

to

(mailing address)

WELL LOCATION:

sec. 3 T. 11 S. R. 9 E. of Smithville
 4 miles E (distance) (direction) (nearest town)


clay	0	20
sand & gravel	20	25
clay	25	130
sand	130	148
clay	148	150

WELL PURPOSE: None
 (home, irrigation, municipal, industrial)

WELL COMPLETION DATA:

- (1) diameter (inches) 4"
- (2) total depth (feet) 150
- (3) static water level (feet) 90 ^{below} ~~above~~ top of ground.
- (4) casing PVC 140
 (material) (depth)
4" if telescope see back.
 (size)
- (5) screen 10 140
 (length) (depth to top)
4" PVC
 (size) (material)
- (6) pump 1
 (HP) (yield gpm)
electric
 (type power)
- (7) electric log no
 (yes or no)
no
 (organization running log)
- (8) how well bottom plugged screen


DRILLERS REMARKS:

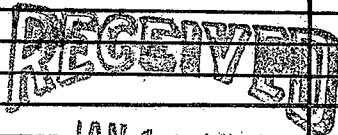

MISS. RD. OF WATER COMMISSIONERS

If well telescopes please sketch and show depths.

GROUND LEVEL

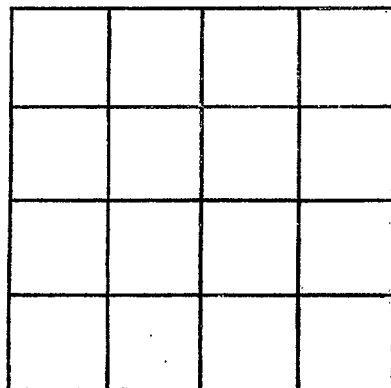

SECTION _____

Please indicate well location X.

ADDITIONAL INFORMATION

If more than one screen,
show locations of each on sketch.