

MONROE  
D 2012  
6/27/79

MISSISSIPPI  
BOARD OF WATER COMMISSIONERS  
416 North State Street  
Jackson, Mississippi 39201

WATER WELL DRILLERS LOG

June 27 1979 date well completed  
MidSouth Drilling firm name  
Monroe county well located

| LANDOWNER: James Drake<br>Rt 3<br>Andrey, MS 38821<br>(mailing address)  | description of formations encountered | from | to  |
|--|---------------------------------------|------|-----|
| WELL LOCATION:<br>sec. 19 T. 12 S. R. 17 W. E. 4<br>4 miles E of Natty<br>(distance) (direction) (nearest town)  | clay & sand                           | 0    | 30  |
| WELL PURPOSE: home<br>(home, irrigation, municipal, industrial)  | clay                                  | 30   | 120 |
| WELL COMPLETION DATA:<br>(1) diameter (inches) 4<br>(2) total depth (feet) 220<br>(3) static water level (feet) 160 below top of ground.<br>(4) casing PVC, 200 (material), (depth), 4 (size) if telescope see back.<br>(5) screen 20, 200 (length), (depth to top), 4" PVC (size), (material)<br>(6) pump 3/4 HP, 10 (yield gpm)<br>electric (type power)<br>(7) electric log no (yes or no)<br>no (organization running log)<br>(8) how well bottom plugged Screen | clay & sand                           | 120  | 135 |
|  | clay                                  | 135  | 147 |
|  | sand                                  | 147  | 160 |
|  | clay                                  | 160  | 175 |
|  | sand                                  | 175  | 220 |

Miss. Board of Water Comm.


AUG 23 1979

RECEIVED

DRILLERS REMARKS:

If well telescopes please sketch and show depths.

GROUND LEVEL

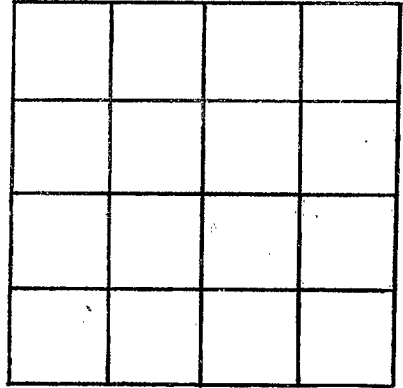

SECTION \_\_\_\_\_

Please indicate well location X.

ADDITIONAL INFORMATION

If more than one screen,  
show locations of each on sketch.