

14

14A

Monroe
D 2013

MISSISSIPPI
BOARD OF WATER COMMISSIONERS
416 North State Street
Jackson, Mississippi 39201

6/1/79
June 19 79

WATER WELL DRILLERS LOG

LEEPER

Monroe

date well completed

firm name

county well located

LANDOWNER:
J.D. Pearce
Rt 1 Smithville
(mailing address)

description of formations encountered	from	to
Top clay	0	15
Red sand	15	60
Red and	60	140
Yellow jointed		
clay		
fine sand	140	150

WELL LOCATION:
sec 34 T 11 N R 9 E
3 miles E of Smithville
(distance) (direction) (nearest town)

WELL PURPOSE: HOME
(home, irrigation, municipal, industrial)

- WELL COMPLETION DATA:
- (1) diameter (inches) 4
 - (2) total depth (feet) 150
 - (3) static water level (feet) 140 below above top of ground.
 - (4) casing 4" 140
(material) (depth)
(size) if telescope see back.
 - (5) screen 10 ft 140
(length) (depth to top)
4" PVC
(size) (material)
 - (6) pump 1/2 5
(HP) (yield gpm)
3 sec
(type power)
 - (7) electric log NO
(yes or no)
(organization running log)
 - (8) how well bottom plugged CAP

DRILLERS REMARKS:


DEPT. OF NATURAL RESOURCES
BUREAU OF LAND & WATER RESOURCES

FEB 24 1981
RECEIVED

FEB 1981
RECEIVED
SXC
18 19 20 21 22 23 24 25 26 27 28 29 30 31 - 11:53 AM '81

If well telescopes please sketch and show depths.

GROUND LEVEL

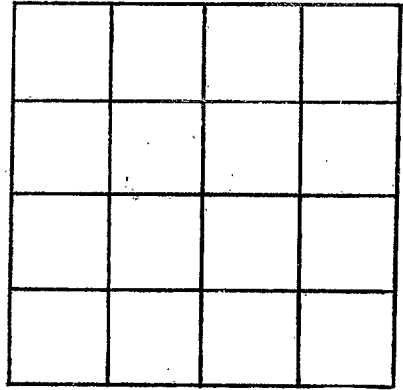

SECTION _____

Please indicate well location X.

ADDITIONAL INFORMATION

If more than one screen, show locations of each on sketch.

