

MONROE
D 2014
10-18-79

MISSISSIPPI
BOARD OF WATER COMMISSIONERS
416 North State Street
Jackson, Mississippi 39201

CODED

WATER WELL DRILLERS LOG

Oct 18 1979 CEEPER Drilling Monroe
date well completed firm name county well located

LANDOWNER: John D. Gray
Rt 3 (Hatch) Amory MS
(mailing address)

description of formations encountered	from	to
TOP CLAY	0	10
GRAY, STICKY, CLAY with LIGNITE STREAKS	10	100
VERY FINE SAND	100	115

WELL LOCATION:
sec. 36 T 17 N R 9 E
S W

miles of (distance) (direction) of (nearest town)

WELL PURPOSE:
(home, irrigation, municipal, industrial)


- WELL COMPLETION DATA:
- (1) diameter (inches) 4"
 - (2) total depth (feet) 115.77
 - (3) static water level (feet) 100 below top of ground
 - (4) casing PVC 105 (material) (depth)
4" (size) if telescope see back.
 - (5) screen 10 ft 105 (length) (depth to top)
2" (size) PVC (material)
 - (6) pump 1 HP 567 (HP) (yield/gpm)
electric 56 gpm (type power)
 - (7) electric log (yes of no) (organization running log)
 - (8) how well bottom plugged PVC CAP

DRILLERS REMARKS:

MISSISSIPPI DEPT. OF NATURAL RESOURCES
BUREAU OF LAND & WATER RESOURCES
FEB 11 1980

If well telescopes please sketch and show depths.

GROUND LEVEL

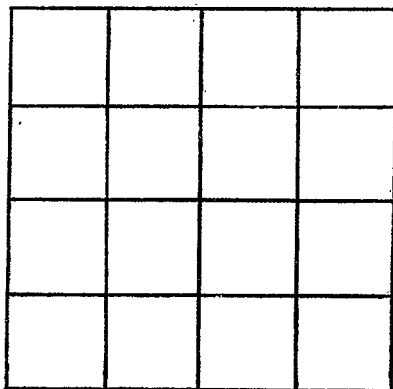

SECTION _____

Please indicate well location X.

ADDITIONAL INFORMATION

If more than one screen,
show locations of each on sketch.