

**MISSISSIPPI DEPARTMENT OF ENVIRONMENTAL QUALITY**

Office of Land and Water Resources

P. O. Box 10631  
Jackson, MS 39289-0631  
**WATER WELL DRILLERS LOG**

COUNTY WELL LOCATED <i>Monroe</i>	
WELL NUMBER <i>D 2021</i>	CODED
DATE WELL COMPLETED <i>5-8-97</i>	

PERMIT NUMBER
NAME OF DRILLING FIRM <i>Rossi Drilling</i>
<i>25090-509</i>

NAME & MAILING ADDRESS OF LANDOWNER <i>Charles Holloway</i>			
<i>60029 Sims Rd</i>			
<i>Smithville MS 38870</i>			
WELL LOCATION: SEC	TOWNSHIP	RANGE	
<i>18</i>	<i>12S</i>	<i>N 9E</i>	<i>11E</i>
DISTANCE	DIRECTION	NEAREST TOWN	
<i>2 1/2</i> Miles	<i>north</i>	<i>MT. ZION RD</i>	
OTHER LANDMARK			
WELL PURPOSE: <u>Home</u> , Irrigation, Municipal, Industrial, Fish Pond, etc.			

PUMP DATA		
PUMP TYPE (Circle One): Submersible, Turbine, Jet, Flowing Well, Other (Describe) _____		
POWER TYPE (Circle One): Electric, Tractor, Diesel, Gasoline, Butane, Other (Describe) _____ H/P <u>_____</u>		
Pump Capacity (GPM)	No. of Stages	Setting Depth  FT.
PUMP TEST		
Well yielded _____ GPM with a drawdown of _____ ft. after _____ hours of pumping		

WELL DATA		
Well Depth <i>253'</i>	Casing Diameter (In.) <i>4"</i>	Casing Length (Ft.) <i>233'</i>
Type of Casing <i>PVC</i>	Hole Depth <i>253'</i>	Depth to Static Water Level <i>105'</i>
TYPE OF COMPLETION: (Circle One or More): <input checked="" type="checkbox"/> Gravel Packed, <input type="checkbox"/> Underreamed, <input type="checkbox"/> Telescoped, <input type="checkbox"/> Natural Development, <input type="checkbox"/> Open Hole, <input type="checkbox"/> Other		
WELL GROUTED TO A DEPTH OF _____ FEET Type Grout (circle one): Cement, Bentonite, or Mix		

LOG DATA	
TYPE OF LOG RUN (Circle One): No Log Run, Electric, Gamma Ray, Density, Sonic, Neutron, Other (Describe) <u>None</u>	
Name of Organization Running Log <u>None</u>	

GEOLOGIC DATA (Office Use Only)			
Surface Elev.	Geologic Unit	Unit Thickness	Depth to Top
Subs. SWL	Date	Analysis	Aquifer Test

SCREEN DATA		
Diameter - Inches <i>4"</i>	Length - Feet <i>20'</i>	Slot Size - Inches <i>0.10</i>
Screen Type <i>PVC</i>	Depth to Bottom - Feet	


Driller's Remarks
Top of Lap Pipe or Reduction in Casing  FEET <input type="checkbox"/> IF TELESCOPED OR MORE THAN ONE SCREEN: USE BACK PAGE

DESCRIPTION OF FORMATIONS ENCOUNTERED	FROM	TO
<i>Clay</i>	<i>0</i>	<i>18</i>
<i>Sand</i>	<i>18</i>	<i>22</i>
<i>B. Blue Clay</i>	<i>22</i>	<i>105</i>
<i>Sand</i>	<i>105</i>	<i>112</i>
<i>B. Blue</i>	<i>112</i>	<i>210</i>
<i>Sand</i>	<i>210</i>	<i>222</i>
<i>Sand &amp; S. sand</i>	<i>222</i>	<i>253</i>

FORMATIONS ENCOUNTERED	FROM	TO
<b>RECEIVED</b>		
<b>MAY 19 1997</b>		
Dept. of Environmental Quality Office of Land & Water Resources		
IF MORE SPACE IS NEEDED, USE BACK		

If well telescopes please sketch and show depths.

GROUND LEVEL

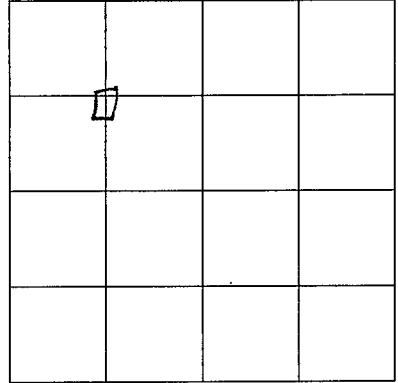

SECTION 14

Please indicate well location X.

ADDITIONAL INFORMATION

If more than one screen,  
show location of each on sketch.