

MISSISSIPPI DEPARTMENT OF ENVIRONMENTAL QUALITY
Office of Land and Water Resources

P. O. Box 10631
Jackson, MS 39289-0631
WATER WELL DRILLERS LOG

COUNTY WELL LOCATED
Monroe

WELL NUMBER **D-2099** CODED

DATE WELL COMPLETED
12-7-00

PERMIT NUMBER

NAME OF DRILLING FIRM
Rossi Drilling

0-509

NAME & MAILING ADDRESS OF LANDOWNER
Donald Richey
PO Box 65
Smithville MS 38870

WELL LOCATION: SEC **17** TOWNSHIP **12** RANGE **9** **N** **W**

DISTANCE _____ DIRECTION _____ NEAREST TOWN _____

Miles _____ of _____

OTHER LANDMARK _____

WELL PURPOSE: Home, Irrigation, Municipal, Industrial, Fish Pond, etc.
FARM use

PUMP DATA

PUMP TYPE (Circle One):
Submersible, Turbine, Jet, Flowing Well,
Other (Describe) _____

POWER TYPE (Circle One):
Electric, Tractor, Diesel, Gasoline, Butane,
Other (Describe) _____ H/P **1**

Pump Capacity (GPM) _____ No. of Stages _____ Setting Depth _____ FT.

PUMP TEST

Well yielded _____ GPM with
a drawdown of _____ ft.
after _____ hours of pumping

WELL DATA

Well Depth 181'	Casing Diameter (In.) 4"	Casing Length (Ft.) 161'
Type of Casing PVC	Hole Depth 181'	Depth to Static Water Level 87'

TYPE OF COMPLETION: (Circle One or More):
Gravel Packed, Underreamed, Telescoped,
Natural Development, Open Hole, Other
(Describe) _____

WELL GROUTED TO A DEPTH OF _____ FEET
Type Grout (circle one): Cement, Bentonite, or Mix

LOG DATA

TYPE OF LOG RUN (Circle One):
No Log Run, Electric, Gamma Ray, Density, Sonic, Neutron,
Other (Describe) **None**

Name of Organization Running Log
None

SCREEN DATA

Diameter - Inches 4"	Length - Feet 20'	Slot Size - Inches .010
Screen Type PVC	Depth to Bottom - Feet 20'	

GEOLOGIC DATA (Office Use Only)

Surface Elev.	Geologic Unit	Unit Thickness	Depth to Top
Subs. SWL	Date	Analysis	Aquifer Test

Driller's Remarks _____

Top of Lap Pipe or Reduction in Casing _____


FEET IF TELESCOPED OR MORE THAN ONE SCREEN: USE BACK PAGE

DESCRIPTION OF FORMATIONS ENCOUNTERED	FROM	TO	FORMATIONS (Continued)	FROM	TO
Clay	0	27			
Sand + Gravel	27	63			
Blue Clay	63	90			
Sand Strip	90	97			
Blue Clay	97	142			
Sand	142	181			

REC'D JUN 25 2001

If well telescopes please
sketch and show depths.

GROUND LEVEL

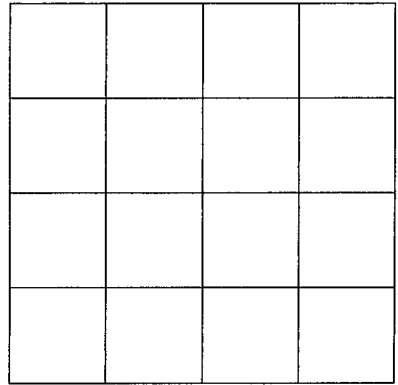

SECTION _____

Please indicate well location X.

ADDITIONAL INFORMATION

If more than one screen,
show location of each on sketch.