

MONROE
E 2001
6-79

MISSISSIPPI
BOARD OF WATER COMMISSIONERS
416 North State Street
Jackson, Mississippi 39201

CODED

WATER WELL DRILLERS LOG

June 1979 LEEPEL Drilling Monroe
 date well completed firm name county well located

LANDOWNER: J.D. Pearce
RT 1
Smithville Ms
 (mailing address)

description of formations encountered	from	to
TOP CLAY	0	30
Blue CLAY	30	90
fine sand	90	110
sticky clay	110	140
Gravel	140	152
(Screemed)	140-150	
Gravel	150	184

WELL LOCATION:
 sec. 7 T. 12 N. R. 16
 (distance) miles (direction) of (nearest town)

WELL PURPOSE: Home
 (home, irrigation, municipal, industrial)

- WELL COMPLETION DATA:
- (1) diameter (inches) 4"
 - (2) total depth (feet) 184
 - (3) static water level (feet) 120 below above top of ground.
 - (4) casing PVC, 140,
 (material) (depth)
4" if telescope see back.
 (size)
 - (5) screen 10 ft, 140
 (length) (depth to top)
4" PVC
 (size) (material)
 - (6) pump 1/2 7 GPM
 (HP) (yield gpm)
electric
 (type power)
 - (7) electric log (yes or no)
 (organization running log)
 - (8) how well bottom plugged PVC Plug


DRILLERS REMARKS:

DEPT. OF NATURAL RESOURCES
 BUREAU OF LAND & WATER RESOURCES

FEB 17 1980
 RECEIVED

If well telescopes please sketch and show depths.

GROUND LEVEL

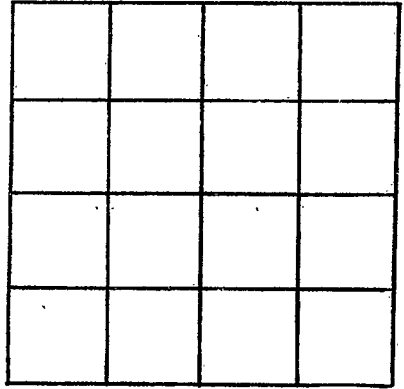

SECTION _____

Please indicate well location X.

ADDITIONAL INFORMATION

If more than one screen, show locations of each on sketch.