

Monroe
E 2003

MISSISSIPPI DEPARTMENT OF NATURAL RESOURCES
 Bureau of Land and Water Resources
 Southport Mall
 P.O. Box 10631
 Jackson, Mississippi 39209
WATER WELL DRILLERS LOG

7-27-87 19 Mid South Drilling Company Monroe
 date well completed firm name county well located

LANDOWNER: Wade Murray Rt. 1 Box 151-A Greenwood Springs, MS 38848 (mailing address)	Description of formations encountered	from	to
WELL LOCATION: sec. 34 T 11S R 10E 16W S N E W 10 miles east of Smithville (distance) (direction) (nearest town)	clay	0	38
	sand	38-	45
	clay	45	70
	sand	70	74
	clay	74	75
	sand	75	77
	clay	77	96
	clay w/ sand streaks	96	100
	sand	100	122
	sand & gravel	122	170
gravel	170	225	
WELL PURPOSE: home (home, irrigation, municipal, industrial)			
WELL COMPLETION DATA:			
(1) diameter (inches) 4			
(2) total depth (feet) 212	rock at 13-30-45-48-94-		
(3) static water level (feet) 132 below XXXX top of ground.	96		
(4) casing PVC, 202 (depth), 4 (size) if telescope see back.			
(5) screen 10' (length), 202' (depth to top), 4" (size), PVC (material)			
(6) pump 1 (HP), 15 (yield gpm), electric (type power)			
(7) electric log no (yes or no), no (organization running log)			
(8) how well bottom plugged screen			
DRILLERS REMARKS:			


RECEIVED

SEP 03 1987

Department of Natural Resources
 Bureau of Land & Water Resources

If well telescopes please sketch and show depths.

GROUND LEVEL

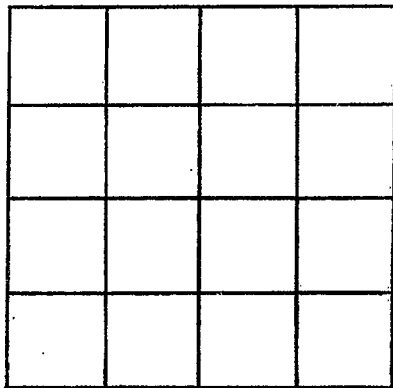

SECTION _____

Please indicate well location X.

ADDITIONAL INFORMATION

If more than one screen,
show locations of each on sketch.