

Monroe  
710  
8-7-68

MISSISSIPPI  
 BOARD OF WATER COMMISSIONERS  
 416 North State Street  
 Jackson, Mississippi 39201

CODED

WATER WELL DRILLERS LOG  
 Herndon-Homan Well & Supply, Inc.

CODED

8-7 1968 Monroe  
 date well completed      name      county well located

LANDOWNER:

Elbert H. Davis  
Box 3 Aberdeen Miss  
 (mailing address)

description of formations encountered

Surface Chy  
Blue clay  
Sand  
Both

from

to

20 28  
28 260  
160 400  
400

WELL LOCATION:

sec. 8 T 13 N R 6 E  
3 miles E of Egypt  
 (distance) (direction) (nearest town)

WELL PURPOSE:

Home  
 (home, irrigation, municipal, industrial)

WELL COMPLETION DATA:

- (1) diameter (inches) 5 1/2
- (2) total depth (feet) 400
- (3) static water level (feet) 100 below above top of ground.
- (4) casing Steel, 42'  
 (material) (depth)
- 5 if telescope see back.  
 (size)
- (5) screen NO  
 (length) (depth to top)
- (size) (material)
- (6) pump 1/2 5  
 (HP) (yield gpm)
- electric  
 (type power)
- (7) electric log NO  
 (yes or no)

(organization running log)

(8) how well bottom plugged Open


OCT 16 1968

DRILLERS REMARKS:

MISS. BD. OF  
 WATER COMM.

If well telescopes please sketch and show depths.

GROUND LEVEL

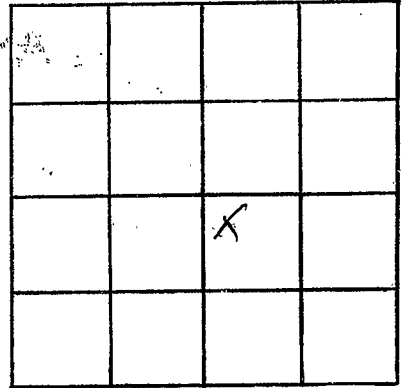

SECTION 8

Please indicate well location X.

ADDITIONAL INFORMATION

If more than one screen, show locations of each on sketch.