

CODED

Monroe
F 12
C-69

MISSISSIPPI
BOARD OF WATER COMMISSIONERS
416 North State Street
Jackson, Mississippi 39201

WATER WELL DRILLERS LOG
Herndon-Homan Well & Supply, Inc.

6-26 1969
date well completed

P. O. Box 42

Monroe
county well located

SHANNON MISSISSIPPI

LANDOWNER: Coleman Gates
Route 1, Box 197
Okolona, Miss.
(mailing address)


description of formations encountered	from
Surface sand	5
Clay	0-25
Bottom clay	25-300
Sand	300-440
Bottom	440

WELL LOCATION:
sec. 4 T 13 N R 6 E
3 miles W of Clared
(distance) (direction) (nearest town)

WELL PURPOSE: Home
(home, irrigation, municipal, industrial)

- WELL COMPLETION DATA:
- (1) diameter (inches) 5"
 - (2) total depth (feet) 440
 - (3) static water level (feet) 86 below/above top of ground.
 - (4) casing Steel 32'6"
(material) (depth)
5" If telescope see back.
(size)
 - (5) screen no
(length) (depth to top)
(size) (material)
 - (6) pump 1/2 (HP) (yield gpm)
Electric
(type power)
 - (7) electric log no
(yes or no)
(organization running log)
 - (8) how well bottom plugged open


DRILLERS REMARKS:

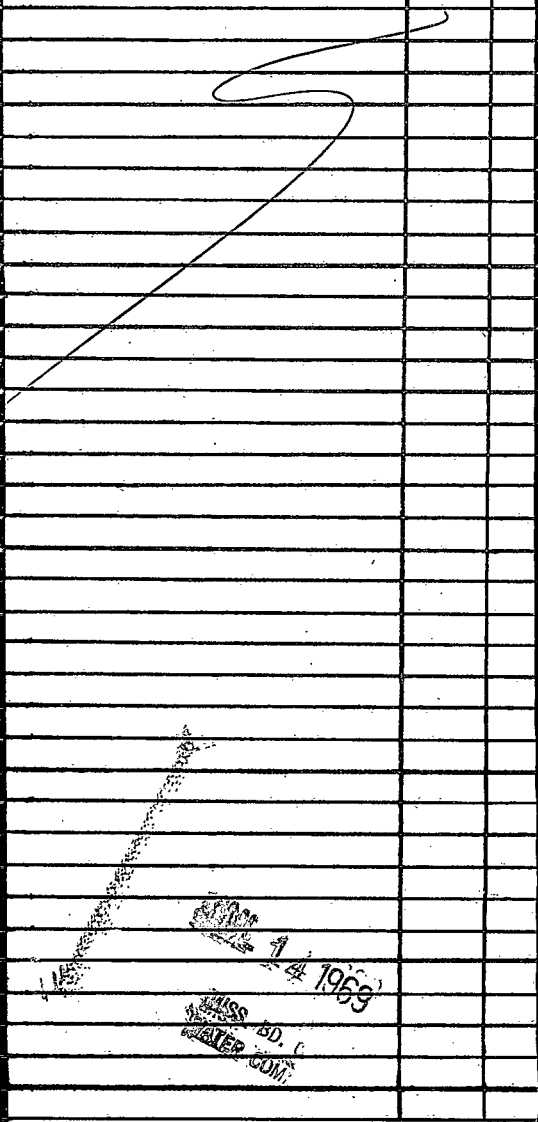

MISSISSIPPI
BOARD OF WATER COMMISSIONERS
JUN 14 1969

If well telescopes please sketch and show depths.

GROUND LEVEL

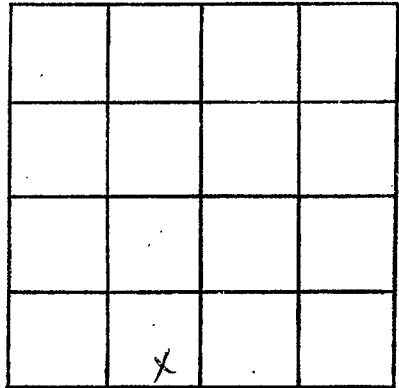

SECTION 4

Please indicate well location X.

ADDITIONAL INFORMATION

If more than one screen, show locations of each on sketch.