

MISSISSIPPI
BOARD OF WATER COMMISSIONERS
416 North State Street
Jackson, Mississippi 39201

CODED

Monroe
F 15
4-24-70

WATER WELL DRILLERS LOG **CODED**

Herndon-Homan Well & Supply, Inc.
P. O. Box 42
Shannon, Mississippi 38860
county well located Monroe

4-24 19 70
date well completed
TURN RT 1 m Past 508

LANDOWNER: Charles Newman
McAllister Rd. 3692891
Route 1
Okolona, Miss 38860
(mailing address)

description of formations encountered	from	to
<u>Surface sand & clay</u>	<u>0</u>	<u>18</u>
<u>Blue clay</u>	<u>18</u>	<u>200</u>
<u>Sand</u>	<u>250</u>	<u>320</u>
<u>Gravel</u>	<u>320</u>	

WELL LOCATION:
25 sec. 13 T. 6 R. 021
2 1/2 miles SW of Wren
(distance) (direction) (nearest town)

WELL PURPOSE: Home
(home, irrigation, municipal, industrial)

- WELL COMPLETION DATA:
- diameter (inches) 5"
 - total depth (feet) 320'
 - static water level (feet) 57 below top of ground.
 - casing Steel 21' 3"
(material) (depth)
5" if telescope see back.
(size)
 - screen no
(length) (depth to top)
(size) (material)
 - pump 1/2 5
(HP) (yield gpm)
Electric
(type power)
 - electric log no
(yes or no)
(organization running log)
 - how well bottom plugged open

CODED


MAY 14 1970

DRILLERS REMARKS:

MISS. BD. OF
WATER COMMISSIONERS

If well telescopes please
sketch and show depths.

GROUND LEVEL

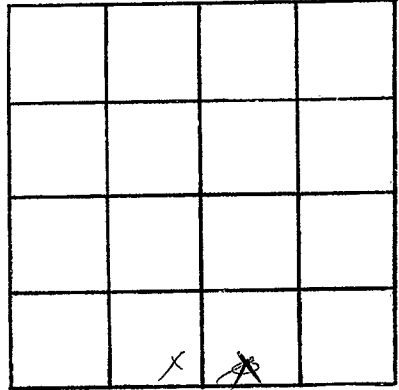

SECTION 2325

Please indicate well location X.

ADDITIONAL INFORMATION

If more than one screen,
show locations of each on sketch.