

MISSISSIPPI
BOARD OF WATER COMMISSIONERS
416 North State Street
Jackson, Mississippi 39201

CODED

WATER WELL DRILLERS LOG

Monroe
F 16
5-5-70

5-5 1970 Hendon Hornum Well Monroe
date well completed firm name & Supply county well located

LANDOWNER: Calvin Clapton
(Contractor) 9th

description of formations encountered	from	to
surface sand	0	18
Blue Clay	18	280
Sand	280	420
Clay	420	

Route 3 Aberdeen Miss
(Mailing address)

WELL LOCATION:
sec. 31 T. 13 N. R. 6 E
1/2 miles E of Esart
(distance) (direction) (nearest town)

WELL PURPOSE: home
(home, irrigation, municipal, industrial)

- WELL COMPLETION DATA:
- (1) diameter (inches) 4 1/2 5"
 - (2) total depth (feet) 420'
 - (3) static water level (feet) 96 below above top of ground.
 - (4) casing Steel 22'
(material) (depth)
5"
(size) if telescope see back.
 - (5) screen 70
(length) (depth to top)
(size) (material)
 - (6) pump 1/2 5
(HP) (yield gpm)
Electric
(type power)
 - (7) electric log no
(yes or no)
 - (organization running log)
 - (8) how well bottom plugged open


CODED

DRILLERS REMARKS:

JUN 15 1970

If well telescopes please sketch and show depths.

GROUND LEVEL

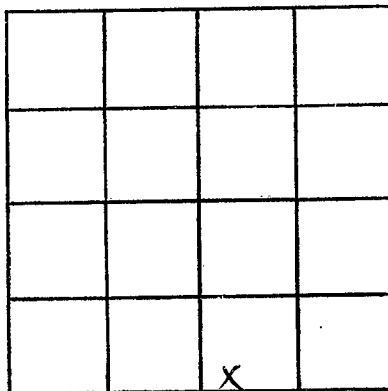

SECTION 31

Please indicate well location X.

ADDITIONAL INFORMATION

If more than one screen,
show locations of each on sketch.