

MISSISSIPPI
BOARD OF WATER COMMISSIONERS
416 North State Street
Jackson, Mississippi 39201

CODED

WATER WELL DRILLERS LOG

Herndon-Homan Well & Supply, Inc. *Monroe*

Monroe
F 17
6-9-70

6-9 19*70*
date well completed

firm name
SHANNON, MISSISSIPPI 38900

county well located

LANDOWNER: *Calvin Clepton*
(Contractor)
Aberdeen, Miss.
(mailing address)

description of formations encountered

from to

<i>Surface sand & clay</i>	<i>0</i>	<i>38</i>
<i>Blue clay</i>	<i>30</i>	<i>200</i>
<i>Sand</i>	<i>20</i>	<i>140</i>
<i>Bottom</i>	<i>340</i>	

WELL LOCATION:
sec. *9* T. *13N* R. *6E*
4 miles *W* of *New Wood*
(distance) (direction) (nearest town)

WELL PURPOSE: *Home*
(home, irrigation, municipal, industrial)

- WELL COMPLETION DATA:
- (1) diameter (inches) *5"*
 - (2) total depth (feet) *340*
 - (3) static water level (feet) *90* below top of ground.
 - (4) casing *Steel* *38'*
(material) (depth)
5" if telescope see back.
(size)
 - (5) screen *70*
(length) (depth to top)
(size) (material)
 - (6) pump *1/2* *5*
(HP) (yield gpm)
Electric
(type power)
 - (7) electric log *no*
(yes or no)
(organization running log)
 - (8) how well bottom plugged *open*

CODED


JUL 20 1970

MISS. Bd. of
WATER COMMISSIONERS

DRILLERS REMARKS:

If well telescopes please sketch and show depths.

GROUND LEVEL

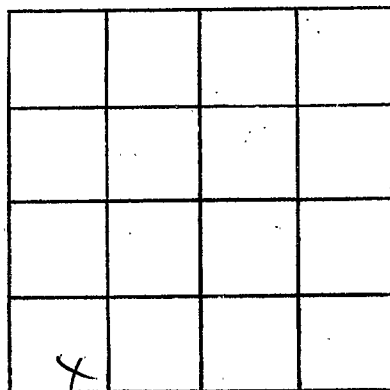

SECTION 9

Please indicate well location X.

ADDITIONAL INFORMATION

If more than one screen, show locations of each on sketch.