

MISSISSIPPI
BOARD OF WATER COMMISSIONERS
416 North State Street
Jackson, Mississippi 39201

CODED

WATER WELL DRILLERS LOG

Herndon-Homan Well & Supply, Inc. *Monroe*

P. O. Box 42 *Chickasaw*

SHANNON, MISSISSIPPI 38809 county well located

Monroe
F 18
6-23-70

6-23 1970
date well completed

contracts
LANDOWNER: Cliff Hanna

Okelona, Miss

(mailing address)

WELL LOCATION:

24 sec 2 T. 13 N R. 6 E
5 miles NW of Aberdeen
(distance) (direction) (nearest town)

WELL PURPOSE: home
(home, irrigation, municipal, industrial)

WELL COMPLETION DATA:

- (1) diameter (inches) 5"
- (2) total depth (feet) 280'
- (3) static water level (feet) 60 below above top of ground.
- (4) casing steel 23'
(material) (depth)
- 5"
(size) if telescope see back.
- (5) screen no
(length) (depth to top)
- (size) (material)
- (6) pump 1/3 5
(HP) (yield gpm)
- Electric
(type power)
- (7) electric log no
(yes or no)

(organization running log)

(8) how well bottom plugged open

DRILLERS REMARKS:

description of fomations encountered

from to

5' sand 0 18
+ clay
13' blue clay 18 160
sand 160 280
Bottom 280


CODED

JUL 20 1970

MISS. BD. OF
WATER COMM.

If well telescopes please sketch and show depths.

GROUND LEVEL

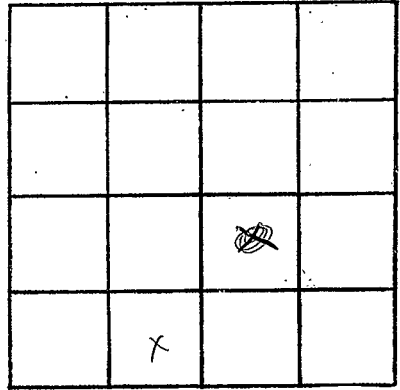

SECTION 2A

Please indicate well location X.

ADDITIONAL INFORMATION

If more than one screen, show locations of each on sketch.