

MONROE
F 20
7-27-70

MISSISSIPPI
BOARD OF WATER COMMISSIONERS
416 North State Street
Jackson, Mississippi 39201

CODED

WATER WELL DRILLERS LOG

7-27 1970 Shendon-Homas Well Monroe
date well completed firm name county well located

LANDOWNER: Robert Clapton
Route 3, Aberdeen Miss
(contractor)
(mailing address)

description of formations encountered	from	to
Surface sand & clay	0	28
White clay	28	240
Sand	240	380
Bottom	380	

WELL LOCATION:
sec. 34 T13 N R. 6 E
2 miles E of Egypt
(distance) (direction) (nearest town)

WELL PURPOSE: home
(home, irrigation, municipal, industrial)

- WELL COMPLETION DATA:
- (1) diameter (inches) 5"
 - (2) total depth (feet) 380'
 - (3) static water level (feet) 140 below top of ground.
 - (4) casing Steel 30'
(material) (depth)
 - 5" if telescope see back.
(size)
 - (5) screen 70
(length) (depth to top)
 - (size) (material)
 - (6) pump 1/2 5
(HP) (yield gpm)
 - Electric
(type power)
 - (7) electric log no
(yes or no)
 - (organization running log)
 - (8) how well bottom plugged open

CODED


AUG 26 1970

DRILLERS REMARKS:

MISS. BD. OF
WATER COMMISSIONERS

If well telescopes please sketch and show depths.

GROUND LEVEL

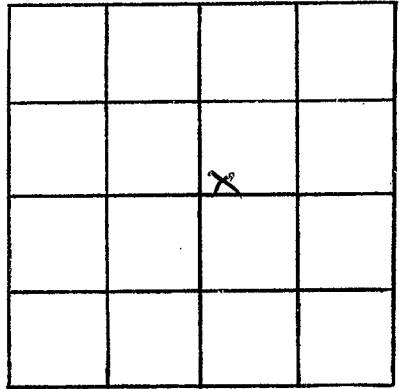

SECTION 32

Please indicate well location X.

ADDITIONAL INFORMATION

If more than one screen, show locations of each on sketch.