

MONROE
F25
4-12-71

MISSISSIPPI
BOARD OF WATER COMMISSIONERS
416 North State Street
Jackson, Mississippi 39201

CODED

WATER WELL DRILLERS LOG
Herndon-Homan Well & Supply, Inc.

P. O. Box 42

Monroe

4-12 19 71
date well completed

SHANNON MISSISSIPPI 18802
firm name county well located

LANDOWNER: Mrs. R. D. Baker, Jr.
Route 1
Okolona, Miss. 38660
(mailing address)

| description of formations encountered | from | to |
|---------------------------------------|------------|------------|
| <u>Surface sand & clay</u> | <u>0</u> | <u>33</u> |
| <u>Other clay</u> | <u>33</u> | <u>180</u> |
| <u>Sand</u> | <u>180</u> | <u>320</u> |
| <u>Bottom</u> | <u>320</u> | |

WELL LOCATION:
sec. 14 T 13 N R. 1 E
1 1/2 miles SW of Neel Wren
(distance) (direction) (nearest town)

WELL PURPOSE: Home
(home, irrigation, municipal, industrial)

- WELL COMPLETION DATA:
- (1) diameter (inches) 5"
 - (2) total depth (feet) 320'
 - (3) static water level (feet) 100 below top of ground.
 - (4) casing Steel 36' 2"
(material) (depth)
 - 5" if telescope see back.
(size)
 - (5) screen no
(length) (depth to top)
 - (size) (material)
 - (6) pump 1/2 5
(HP) (yield gpm)
 - Electric
(type power)
 - (7) electric log no
(yes or no)
 - (organization running log)
 - (8) how well bottom plugged open

CODED


MAY 12 1971

DRILLERS REMARKS:

MISS. RD. OF
WATER COMMISSIONERS

If well telescopes please sketch and show depths.

GROUND LEVEL

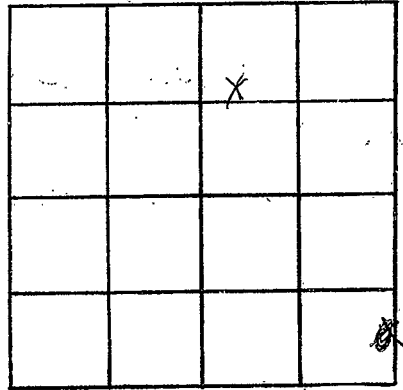

SECTION 14

Please indicate well location X.

ADDITIONAL INFORMATION

If more than one screen,
show locations of each on sketch.