

MONROE
F 26
6-14-71

MISSISSIPPI
BOARD OF WATER COMMISSIONERS
416 North State Street
Jackson, Mississippi 39201

CODED

WATER WELL DRILLERS LOG

Herndon-Homan Well & Supply, Inc. *Monroe*

date well completed 6-14 1971 P. O. Box 42
PAST STORE 2ND HOUSE OUTLET *BLANNOR, MISSISSIPPI 39009* county well located

LANDOWNER *Melvin R. Haskell*
Route 1, Box 373A
Nettleton, Miss.
(mailing address)

description of formations encountered	from	to
<i>Surface sand clay</i>	<i>0</i>	<i>28</i>
<i>Blue clay</i>	<i>28</i>	<i>180</i>
<i>Sand</i>	<i>180</i>	<i>220</i>
<i>Bottom</i>	<i>220</i>	

WELL LOCATION:
sec. *11* T. *13* N. R. *6* E. S. *5* W.
2 miles *N* of *Nettleton*
(distance) (direction) (nearest town)

WELL PURPOSE: *home*
(home, irrigation, municipal, industrial)

- WELL COMPLETION DATA:
- (1) diameter (inches) *5"*
 - (2) total depth (feet) *320*
 - (3) static water level (feet) *120'* below top of ground.
 - (4) casing *Stainless 33'*
(material) (depth)
5" if telescope see back.
(size)
 - (5) screen *no*
(length) (depth to top)
(size) (material)
 - (6) pump *1/2* (HP) *5* (yield gpm)
electric
(type power)
 - (7) electric log *no*
(yes or no)
(organization running log)

CODED

(8) how well bottom plugged *open*


DRILLERS REMARKS:

III 12 1971

MISSISSIPPI
BOARD OF WATER COMMISSIONERS

If well telescopes please sketch and show depths.

GROUND LEVEL

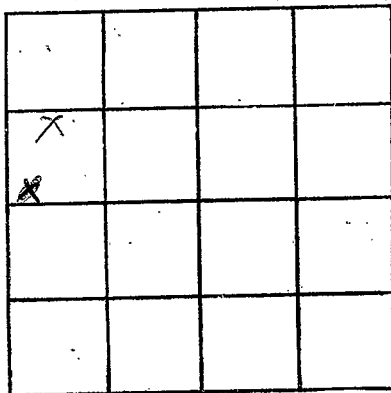

SECTION 11

Please indicate well location X.

ADDITIONAL INFORMATION

If more than one screen,
show locations of each on sketch.