

MONROE
 F 27
 4-6-71

MISSISSIPPI
 BOARD OF WATER COMMISSIONERS
 416 North State Street
 Jackson, Mississippi 39201

CODED

WATER WELL DRILLERS LOG

Bernard-Roman Well & Supply, Inc.

P. O. Box 42

Monroe

4-6 19 71
 date well completed

SEANBY IN MISSISSIPPI 18866 county well located

LANDOWNER: Allison Jenkins, Jr.

Description of formations encountered

from to

Route 1

Surface sand & clay

0 28

Okolona, Miss.

Blue clay

28 200

(mailing address)

Sand

200 340

Bottom

340

WELL LOCATION:

sec. 8 T. 13 N. R. 6 E.

S W

4 1/2 miles W of New Wood

(distance) (direction) (nearest town)

WELL PURPOSE:

Home

(home, irrigation, municipal, industrial)

WELL COMPLETION DATA:

(1) diameter (inches) 5

(2) total depth (feet) 340'

(3) static water level (feet) 120 below top of ground.

(4) casing Steel, 31' (material) (depth)

5" (size) If telescope see back.

(5) screen no (length) (depth to top)

(size) (material)

(6) pump 1 (HP) 3 (yield gpm)

Electric (type power)

(7) electric log no (yes or no)

(organization running log)

(8) how well bottom plugged open

CODED


MAY 12 1971

DRILLERS REMARKS:

MISS. BD. OF WATER COM.

If well telescopes please sketch and show depths.

GROUND LEVEL

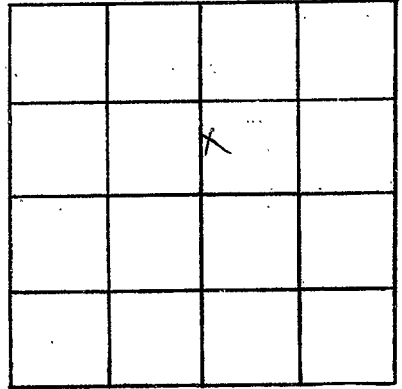

SECTION 8

Please indicate well location X.

ADDITIONAL INFORMATION

If more than one screen, show locations of each on sketch.