

MONROE

OF28

9-67

MISSISSIPPI BOARD OF WATER COMMISSIONERS

**CODED**

**WATER WELL DRILLERS LOG**

Date: 9-1, 1967, Driller: Horton-Homan Well & Supply, Inc. County: Monroe  
 (When well drilled) P. O. Box 42 (Where well is located)  
SHAWHAN, MISSISSIPPI 38868

(1) Owner of Land: Leavel Sassor  
 (Name)

At 3 Box 73B, Aberdeen, Miss.  
SWNW (Address) 35 135

(2) Location: 1/4, 1/4, Sec. 13, T. 16E  
4 miles NW of Aberdeen  
 (distance) (direction) (Nearest Town)

(3) Topography: Flat  
 (Hilly) (Flat) (Level)

(4) Purpose of Well: Home  
 (Domestic Irrigation  
 Municipal, Industrial, Other)

**Information upon completion of well:**

(1) Diameter 5 inches.

(2) Total Depth 220 feet.

(3) Water Level 75 feet below top of ground.

(4) Cased to 27' 7", Size 5"

(5) Screen: Size NONE, Length \_\_\_\_\_.

(6) Were any formations sealed against pollution?  
✓ yes, \_\_\_\_\_ no.

If YES depth of formation 25

Why surface & sand

Drillers Remarks: \_\_\_\_\_

Yield in gpm: 5

Size pump: 1 1/2 HP Sub.

Type power: electric

Description & Color of Materials  
 Sand, Clay, Red Clay, Shell, etc.


Thick-  
 ness  
 Feet

Depth  
 Feet

surface sand  
& clay  
Blue clay  
Sand  
Bottom

0  
25  
25  
100  
220

**CODED**

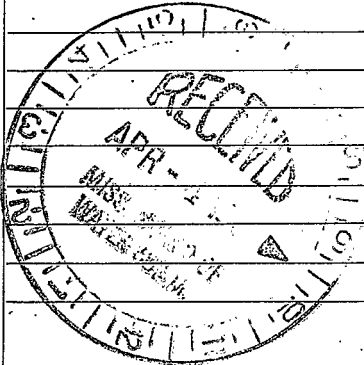

Mail this copy to Board of Water Commissioners 429 Miss. St. Jackson, Miss.

