

MONROE MISSISSIPPI BOARD OF WATER COMMISSIONERS

F30

5-20-65

WATER WELL DRILLERS LOG

**CODED**

Herndon-Homan Well & Supply, Inc.

Date: May 20, 1965, Driller: SHANNON (Name) P. O. Box 42 County Monroe MISSISSIPPI 38868

(1) Owner of Land: Edney O. Herndon  
McAlister Rd. 3698085 (Name)  
At: Aberdeen, Miss  
 (Address) 123  
SE 1/4, SE 1/4, Sec 25 T. 135 R. 6E  
6 miles (distance), NW (direction), of Aberdeen (Nearest Town)

(2) Location: SE 1/4, SE 1/4, Sec 25 T. 135 R. 6E

(3) Topography: Flat  
 (Hilly) (Flat) (Level)

(4) Purpose of Well: Domestic  
 (Domestic Irrigation, Municipal, Industrial, Other)

Description & Color of Materials Sand, Clay, Red Clay, Shell, etc.	Thick-ness Feet	Depth Feet
<u>sand &amp; clay</u>	<u>0</u>	<u>30</u>
<u>some clay</u>	<u>30</u>	<u>160</u>
<u>Sand</u>	<u>160</u>	<u>250</u>
<u>Bottom</u>	<u>250</u>	<u>250</u>

Information upon completion of well:

(1) Diameter 5 inches.

(2) Total Depth 260 feet.

(3) Water Level 47' feet below top of ground.

(4) Cased to 32', Size 5"

(5) Screen: Size —, Length —


(6) Were any formations sealed against pollution?  
 yes,  no.

If YES depth of formation 30

Why surface & sand

Drillers Remarks:

**CODED**

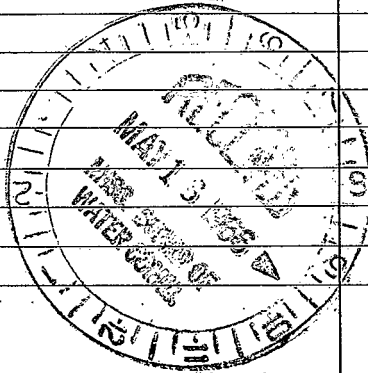

(Use Back Side)

Well No.

[The text in this section is extremely faint and illegible. It appears to be a list or a series of entries, possibly a table with multiple columns. Some faint words like "No.", "Name", and "Address" might be discernible, but the specific content is unreadable.]