

MONROE

F31

3-68

MISSISSIPPI
 BOARD OF WATER COMMISSIONERS
 416 North State Street
 Jackson, Mississippi 39201

CODED

WATER WELL DRILLERS LOG

Merndon-Homan Well & Supply, Inc.

P. O. Box 42

MONROE

3-9 1968
date well completed

SHANNON, MISSISSIPPI county well located

LANDOWNER:

R. F. Bridgman

description of formations encountered

from to

Rt 1 Aberdeen Miss
(mailing address)

surface sand

0 15

blue clay

15 160

hard

160 280

3' AT

280

WELL LOCATION:

24 sec 25 T 13 N R 6 E
 S W
 6 miles NW of Aberdeen
 (distance) (direction) (nearest town)

WELL PURPOSE:

Home
(home, irrigation, municipal, industrial)

WELL COMPLETION DATA:

(1) diameter (inches) 5

(2) total depth (feet) 280

(3) static water level (feet) 80 below above top of ground.

(4) casing Steel 18' 7" (material) (depth)

— If telescope see back. (size)

(5) screen none (length) (depth to top)

(size) (material)

(6) pump 1/2 5 (HP) (yield gpm)

electric (type power)


(7) electric log SD (yes or no)

(organization running log)

(8) how well bottom plugged open

DRILLERS REMARKS:

CODED

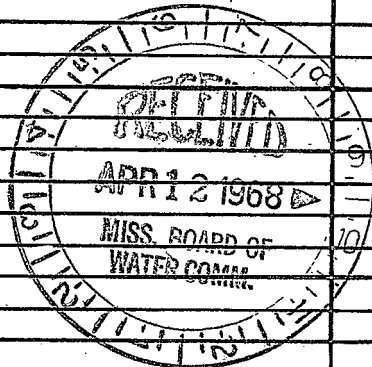

If well telescopes please sketch and show depths.

GROUND LEVEL

	X	✓	

SECTION 2-F

Please indicate well location X.

ADDITIONAL INFORMATION

If more than one screen,
show locations of each on sketch.