

Monroe
F32
 7-68

MISSISSIPPI
 BOARD OF WATER COMMISSIONERS
 416 North State Street
 Jackson, Mississippi 39201

CODED

WATER WELL DRILLERS LOG
 P. O. Box 42
 SHANNON, MISSISSIPPI

7-15 1968 date well completed
 firm name
 county well located

HOUSE BEHIND SDRK

LANDOWNER:
 McCallister Rd. 256 B647
 J.W. *Howell*
 Rt 1 DELOBA, MISS (mailing address)


description of formations encountered	from	to
Surface Sand	0	38
+ clay	38	201
Black clay	201	320
Sand	320	
Bole		

WELL LOCATION:
 sec. 11 T 13 N R. 6 E
 S W
 2 miles W of Wood
 (distance) (direction) (nearest town)

WELL PURPOSE:
 (home, irrigation, municipal, industrial)

- WELL COMPLETION DATA:
- (1) diameter (inches) 5 9
 - (2) total depth (feet) 320'
 - (3) static water level (feet) 115' below top of ground.
 - (4) casing Steel (4 1/2" (material) (depth)
5 4 if telescope see back.
 (size)
 - (5) screen no (length) (depth to top)
 (size) (material)
 - (6) pump 1/3 (5 (HP) (yield gpm)
electric (type power)
 - (7) electric log no (yes or no)
 (organization running log)
 - (8) how well bottom plugged open


CODED

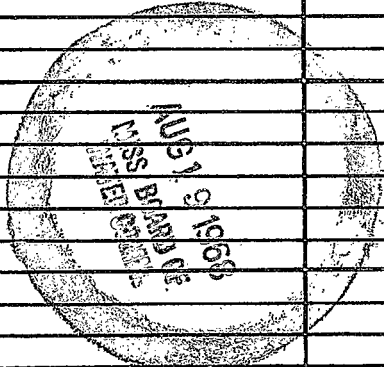

DRILLERS REMARKS:

If well telescopes please sketch and show depths.

GROUND LEVEL

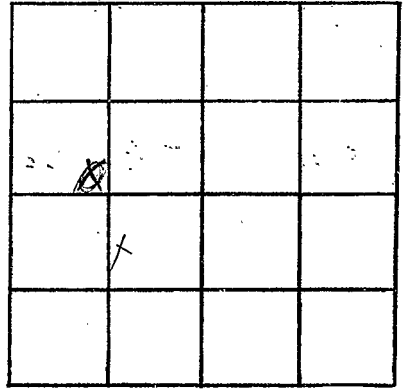

SECTION 11

Please indicate well location X.

ADDITIONAL INFORMATION

If more than one screen, show locations of each on sketch.