

MONROE

F33

4-13-61

WATER WELL DRILLERS LOG

CODED

E300

HERNDON WELL & SUPPLY CO.

MONROE

Date: April 13, 1961, Driller:

P.O. BOX 42

County ~~Shannon~~

SHANNON, MISSISSIPPI

GO PAST SHAW'S 304 house ONL past BRIDGE

(1) Owner of Land: Wesley Crawford
(Name)

Description & Color of Materials
Sand, Clay, Red Clay, Shell, etc.

Thick-
ness
Feet

Depth
Feet

Okolona, Miss
(Address)

Surface sand

0

(2) Location: NW NE 1/4, NE 1/4, Sec. 16, T. 133, R. 6E

clay

2 miles East, of Okolona
(distance) (direction) (Nearest Town)

Blue rocks

15

(3) Topography: Flat
(Hilly) (Flat) (Level)

sand

160

(4) Purpose of Well: Home
(Domestic Irrigation
Municipal, Industrial, Other)

Bottom

280

Information upon completion of well:

(1) Diameter 4 inches.

(2) Total Depth 280 feet.

(3) Water Level 70 feet below top of ground.

(4) Cased to 22', Size 4"

(5) Screen: Size —, Length —


(6) Were any formations sealed against pollution?
✓ yes, — no.

If YES depth of formation 20'

Why Surface & sand

Drillers Remarks:

CODED

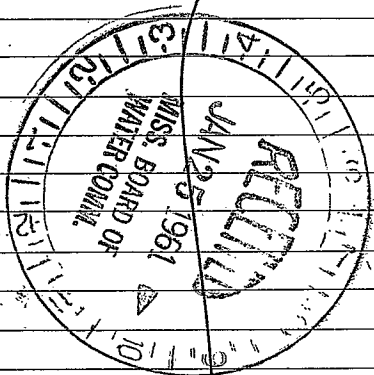

(Use Back Side)

Well No.

100

100

